


A-14, T85, R45E

CERTIFIED RECORD OF LAND CORNER MONUMENTATION

History of original corner establishment: *NONE*

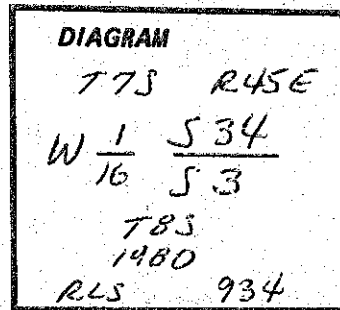

Description of corner evidence found: *NONE*

Description of monument and accessories I established to perpetuate the original location of this corner: *AT CALCULATED POSITION I SET A 2" x 30" GALV. IRON PIPE W/ BRASS CAP STAMPED AS SHOWN ABOVE, FROM WHICH:*
NEW BT, 9" FIR, SCRIBED "W $\frac{1}{16}$ S 34 BT" BEARS N 67° W, 47.1 FT.
NEW BT, 10" FIR, SCRIBED "W $\frac{1}{16}$ S 3 BT" BEARS S 18 $\frac{3}{4}$ ° E, 29.1 FT.

I SET THE 2" PIPE 28" IN GROUND AND SET STONES AROUND IT.
I SET A STEEL POST 3' W. OF COR. W/ SIGNS 54-2 & 54-9
AND A STEEL POST 3' S. OF COR. W/ SIGN 54-2.

I PAINTED A RED BAND AROUND BOTH BT'S, AND TAGGED THEM W/ SIGN 54-3

REGISTERED
 PROFESSIONAL
 LAND SURVEYOR

Victor M. McLind
 OREGON
 JULY 17, 1970
 VICTOR M. McLIND
 934

I HEREBY CERTIFY THE ABOVE CORNER MONUMENT WAS ESTABLISHED AS HEREIN DESCRIBED ON JUNE 10, 1980

WITNESS: *Doug McFord*

Office of..... County of.....
 State of....., I hereby certify that the within instrument was filed in this office for record on the..... day of....., 19.....
 by..... (COUNTY OFFICIAL) (DEPUTY)

Form R6-7100-57 (9/71)

FILED Aug 11, 1980
 BAKER COUNTY SURVEYOR
 SURVEY NO. 7-45-61
8-45-41

☆ GPO-798-276

Doug