


CERTIFIED RECORD OF LAND CORNER MONUMENTATION

History of original corner establishment: CORNER ESTABLISHED IN 1873
BY BARIN & WALDEN UNDER G.L.D. CONTRACT.
SURVEYOR GENERAL'S RECORDS STATE;
SET SANDSTONE 16x10x6 8IN. IN GROUND FOR
CORNER TO SECS. 34, 35, 2, 3

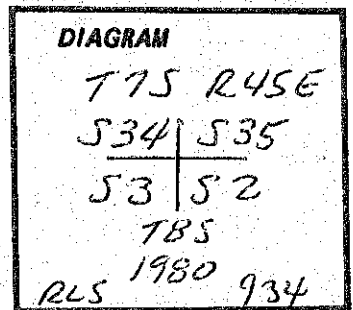

Description of corner evidence found: FND. SANDSTONE 16"x10"x6", LYING 1' NORTH OF
OLD E-W FENCE LINE, WITH 6 GROOVES ON N. FACE, 6 GROOVES ON S. FACE,
4 NOTCHES ON W. EDGE, AND 2 NOTCHES ON E. EDGE.

Description of monument and accessories I established to perpetuate the
original location of this corner: IN PLACE OF FND. STONE I SET A 2"x30" GALV. IRON
PIPE W/BRASS CAP STAMPED AS SHOWN ABOVE, FROM WHICH I
NEW BT, 9" FIR, SCRIBED "T85 R45E S3 BT" BEARS S32°W, 10.8 FT.
NEW BT, 9" FIR, SCRIBED "T85 R45E S2 BT" BEARS S22½°E, 40.8 FT.
NEW BT, 10" FIR, SCRIBED "T75 R45E S35 BT" BEARS N58°E,
NEW BT, 7" PINE, SCRIBED "T75 R45E S34 BT" BEARS N68°W, 37.1 FT.
I SET THE 2" PIPE 27" IN GROUND AND BURIED STONE ALONGSIDE.
I SET A STEEL POST 3' FROM CORNER W/SIGNS 54-2 & 54-4.
I PRINTED A RED BAND AROUND ALL BT'S, AND TAGGED THEM W/SIGN 54-3.

REGISTERED
PROFESSIONAL
LAND SURVEYOR

Victor M. Mc Lind

OREGON
JULY 17, 1970
VICTOR M. McLIND
934

I HEREBY CERTIFY THE ABOVE CORNER MONUMENT
WAS RE-ESTABLISHED AS HEREIN DESCRIBED ON
MAY 26, 1980.

WITNESS: *Doug Mc Lind*

Office of..... County of.....
State of..... I hereby certify that the within instrument was filed in this office
for record on the..... day of....., 19.....
..... by
(COUNTY OFFICIAL) (DEPUTY)

Doug