


CERTIFIED RECORD OF LAND CORNER MONUMENTATION

History of original corner establishment:

Set granite rock 16 x 11 x 6 ins. 11" in ground for corner to Sec's. 3, 4 & 33, 34 marked with 3 notches on the east and west sides, from which
 A cottonwood 10" dia. bears N 81 E, 15 lks. dist. marked T 6 S R 45 E, S 34 BT.
 A cottonwood 12" dia. bears N 52 W, 17 lks. dist. marked T 6 S R 45 E, S 33 BT.
 A fir 14" dia. bears S 5 W, 70 lks. dist. marked T 7 S R 45 E, S 4 BT.
 A fir 12" dia. bears S 31 E, 44 lks. dist. marked T 7 S R 45 E S 3 BT.

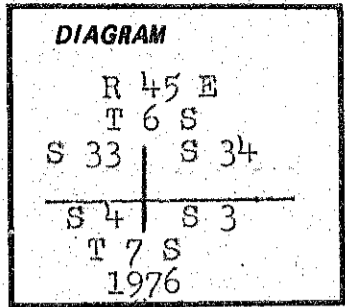

Description of corner evidence found:

Found that the corner itself has been destroyed due to flash flooding down the canyon as corner was only 9 lks. north of creek at the time it was set.

Found both firs and evidence of the cottonwood in Section 4 of which the bearing and distances all fit. The firs were so deteriorated that no scribing was evident.

Description of monument and accessories I established to perpetuate the original location of this corner:

I relocated the section corner using the original GLO notes, and set a brass cap on a 2" pipe 30" long and flared at the bottom. I stamped the cap as shown in the above diagram and buried the monument in a large mound of stone. From which I set new corner accessories:
 A red fir 40" in dia. bears N 34 00 W, 81.84 feet dist. and scribed T 6 S R 45 E S 34 BT.
 A pine 28" in dia. bears N 40 30 E, 142.43 feet dist. and scribed T 6 S R 45 E, S 33 BT.
 A red fir 40" dia. bears S 29 30 E 33.66 feet dist. and scribed T 7 S R 45 E S 3 BT.
 A spike in point of a vertical rock ledge approx. 20 feet high which bears S 74 30 W 73.80 feet and being the only available object in Section 4 T 7 S R 45 E that is suitable as a bearing object.

REGISTERED
PROFESSIONAL
LAND SURVEYOR

James H. Hambleton

OREGON
JULY 10, 1964
JAMES H. HAMBLETON
645

Office of..... County of.....
 State of..... I hereby certify that the within instrument was filed in this office
 for record on the..... day of....., 19.....

..... by.....
 (COUNTY OFFICIAL) (DEPUTY)

FILED March 23, 1981

Form R6-7100-57 (9/71)

BAKER COUNTY SURVEYOR
 SURVEY NO. 7-45-68

† GPC-798-276

*Rec'd from U.S.F.S
 (Glen Weideman) 3-23-81*