


CERTIFIED RECORD OF LAND CORNER MONUMENTATION

History of original corner establishment:

No previous history.

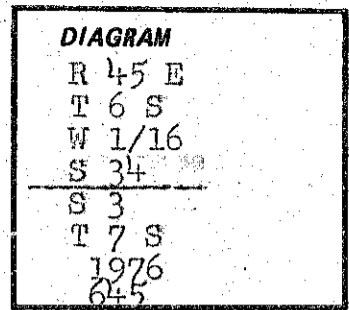

Description of corner evidence found:

No previous corner set.

Description of monument and accessories I established to perpetuate the original location of this corner:

I set a Brass Cap on a 2" pipe 30" long and flared at the bottom. I stamped the cap as shown in the above diagram and buried the monument in a mound of stone. From which I set two bearing trees:

A larch 8" in dia. which bears N 26 00 W, 43.75 feet and scribed 1/16 S 34 BT.

A pine 9" in dia. which bears S 21 00 W, 25.65 feet and scribed 1/16 S 3 BT.

REGISTERED PROFESSIONAL LAND SURVEYOR

James H. Hambleton

OREGON JULY 10, 1961 JAMES H. HAMBLETON 645
--

Office of..... County of.....
State of..... I hereby certify that the within instrument was filed in this office
for record on the..... day of....., 19.....

..... by.....
(COUNTY OFFICIAL) (DEPUTY)

FILED March 23, 1981
BAKER COUNTY SURVEYOR
SURVEY NO. 7-45-63

Form R6-7100-57 (9/71)

☆ GPC-798-276

*Rec'd from U.S.F.S.
(Glen Weideman) 3-23-81*