


CERTIFIED RECORD OF LAND CORNER MONUMENTATION

History of original corner establishment:

A basalt rock 21 x 16 x 12 in. 16" in ground for 1/4 sec. corner marked 1/4 on the west side and a raised mound of rock along side pits impracticable.

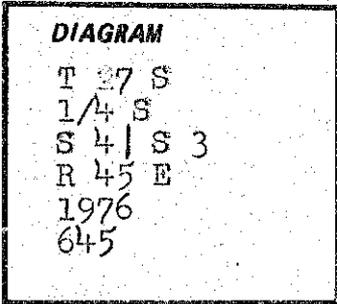

Description of corner evidence found:

Made extensive search - found no evidence of corner and found the calls along this line do not fit the topog.

Description of monument and accessories I established to perpetuate the original location of this corner:

Due to the fact that I found no evidence of the original corner, I established a new 1/4 corner by proportionate measurements. I set a brass cap on a 2" pipe 30" long and flared at the bottom. Buried pipe in the ground and placed a large mound of stone about it. From which I set two bearing trees:

A white fir 12" dia. bears S 73 30 W, 26.8 feet and scribed 1/4 S BT.

A red fir 12" dia. bears N 78 00 E, 33.39 feet and scribed 1/4 S BT.

Brass cap is stamped as shown in above diagram.

REGISTERED
PROFESSIONAL
LAND SURVEYOR

James H. Hambleton

OREGON
JULY 10, 1964
JAMES H. HAMBLETON
645

Office of..... County of.....
State of..... I hereby certify that the within instrument was filed in this office
for record on the..... day of....., 19.....

..... by.....
(COUNTY OFFICIAL) (DEPUTY)

FILED March 23, 1981

BAKER COUNTY SURVEYOR

SURVEY NO. 7-45-70

Form R6-7100-57 (9/71)

☆ GPO-796-276

*Rec'd from U.S.F.S.
(Glen Weideman) 3-23-81*