

CERTIFIED RECORD OF LAND CORNER MONUMENTATION


History of original corner establishment:

Corner established by W. B. Barr under GLO contract no. 443 dated May 29, 1882.

Surveyor General records state:

Set granite boulder 10 x 10 x 7 ins, 7 inches in the ground for 1/4 Sec corner, marked 1/4 on the North side from which:

- A pine 13 ins diam bears N 57° E, 44 lks dist marked 1/4 S BT
- A pine 22 ins diam bears S 67° E, 68 lks dist marked 1/4 S BT

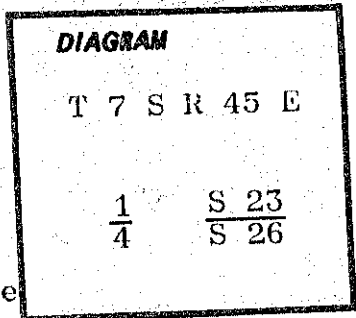

Description of corner evidence found:

Found a granite stone 10 x 10 x 7 inches and marked 1/4 buried in a roadway, 8 inches below surface.

Description of monument and accessories I established to perpetuate the original location of this corner:

Set a 2½ inch brass cap on a 1 inch iron pipe 31 inches long and buried 6 inches below roadway surface.

Brass cap marked thus:

T 7 S R 45 E

$\frac{1}{4}$	$\frac{S\ 23}{S\ 26}$
---------------	-----------------------

CS 1980

I hereby certify that the above described monuments were properly established on July 7, 1980, under my supervision and witnessed by Brad Gordon, Tom Fisk and Jim DeMastus.

REGISTERED PROFESSIONAL LAND SURVEYOR

James D. Hanley

OREGON
SEPTEMBER 23, 1977
JAMES D. HANLEY
1206

Office of..... County of.....
 State of....., I hereby certify that the within instrument was filed in this office
 for record on the..... day of....., 19.....
 by
 (COUNTY OFFICIAL) (DEPUTY)