

CERTIFIED RECORD OF LAND CORNER MONUMENTATION


History of original corner establishment:

Corner established by W. B. Barr under GLO contract no. 443 dated May 29, 1882.

Surveyor General records state:

Set volcanic rock 12 x 10 x 9 ins 8 ins in the ground for 1/4 sec cor marked 1/4 on the west side from which:

- A quaking aspen 3 ins in diam bears S 48° E, 90 lks dist marked 1/4 S BT
- A quaking aspen 5 ins in diam bears S 10° W, 87 lks dist marked 1/4 S BT

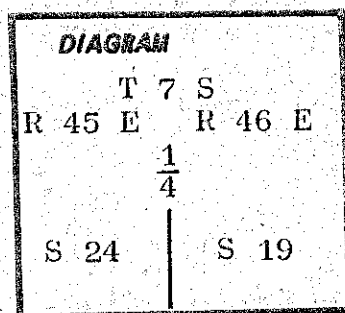


Description of corner evidence found:

An ancient fence corner from which the fence runs north and west.

Description of monument and accessories established to perpetuate the original location of this corner:

Set a 2 1/2 inch brass cap on a 1 inch iron pipe 31 inches long and projecting 5 inches out of the ground with a surrounding rock mound.

Brass cap marked thus:

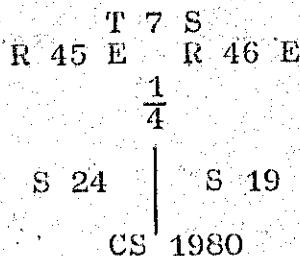

I hereby certify that the above described monument was properly established on July 7, 1980, under my supervision and witnessed by Brad Gordon, Tom Fisk and Jim DeMastus.

REGISTERED
PROFESSIONAL
LAND SURVEYOR

James D. Hanley

OREGON
SEPTEMBER 23, 1977
JAMES D. HANLEY
1206

Office of..... County of.....
 State of....., I hereby certify that the within instrument was filed in this office
 for record on the..... day of....., 19.....
 by
 (COUNTY OFFICIAL) (DEPUTY)

Form R6-7100-51 (9/71)

FILED April 13, 1981
 BAKER COUNTY SURVEYOR
 SURVEY NO. 7-45-74