


**CERTIFIED RECORD OF LAND CORNER MONUMENTATION**

J-19

**History of original corner establishment:**

Corner was established in 1882 by W. B. Barr, Deputy Surveyor under contract No. 443. Surveyor General's records state: Set post 4' long 4" dia. 24" in ground for  $\frac{1}{4}$  Sec. corner marked  $\frac{1}{4}$  on the North side from which:  
 A Fir 5" dia. bears N 30 W, 38 lks. dis. marked  $\frac{1}{4}$  S BT.  
 A Pine 17" dia. bears S 41 E, 10 lks. dis. marked  $\frac{1}{4}$  S BT.

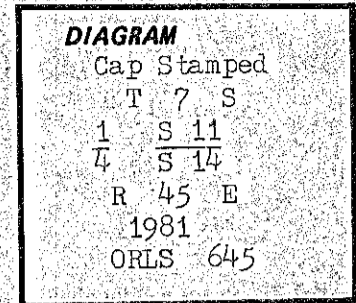

**Description of corner evidence found:**

At the assumed  $\frac{1}{4}$  corner location I found no evidence of original  $\frac{1}{4}$  corner because corner location fall in an old burn. Thus, the bearing trees and posts had been destroyed. However, I found a 48" Pine line tree as described in GLO notes; that is now a 52" stump and GLO topog calls along the section line check with actual measured distances. Tree is 1162.62' measured (GLO 1161.6') E. of  $\frac{1}{4}$  corner location.

**Description of monument and accessories I established to perpetuate the original location of this corner:**

Using the above found data I reconstructed the position of the corner and set a  $2\frac{1}{2}$ " brass cap on a 30" galv. iron pipe 2" above the surface of the ground from which I set 2 new bearing trees:

- A Larch 11" dia. bears N 22 30 W, 12.75' horiz. dist. and scribed  $\frac{1}{4}$ S S11-BT.
- A Larch 10" dia. bears S 23 30 W, 19.42' horiz. dist. and scribed  $\frac{1}{4}$ S S 14 BT.

I hereby certify the above corner monument was established as herein described during June 1981.

Witnesses; Mike Cain  
 Mike Cain, Inst. Man  
Mark Cain  
 Mark Cain, Chairman

REGISTERED  
 PROFESSIONAL  
 LAND SURVEYOR

*James H. Hambleton*

OREGON  
 JULY 10, 1964  
 JAMES H. HAMBLETON  
 645

Office of..... County of.....  
 State of..... I hereby certify that the within instrument was filed in this office  
 for record on the..... day of....., 19.....  
 ..... by .....  
 (COUNTY OFFICIAL) (DEPUTY)