


CERTIFIED RECORD OF LAND CORNER MONUMENTATION

L-19

History of original corner establishment:
No previous history.

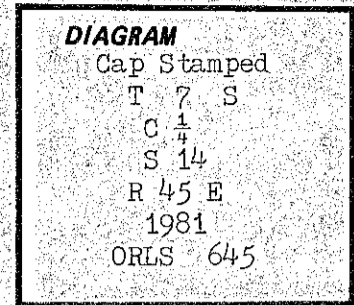

Description of corner evidence found:
None

Description of monument and accessories I established to perpetuate the original location of this corner:

At the $\frac{1}{4}$ corner location I set a $2\frac{1}{2}$ " brass cap on a 30" galv. iron pipe, 2" above the surface of the ground, from which I set two bearing trees:

A Pine 8" dia. bears N 25 40 W, 32.80' horiz. dist. and scribed C $\frac{1}{4}$ S 14 BT.

A Doug. fir 6" dia. bears S 71 10 W, 10.25' horiz. dist. and scribed C $\frac{1}{4}$ S 14 BT.

I hereby certify the above corner monument was established as herein described during June 1981.

Witnesses: Mike Cain
Mike Cain, Inst. Man

Mark R. Cain
Mark Cain, Chairman

REGISTERED
PROFESSIONAL
LAND SURVEYOR

James H. Hambleton

OREGON
JULY 10, 1964
JAMES H. HAMBLETON
645

Office of..... County of.....
State of..... I hereby certify that the within instrument was filed in this office
for record on the..... day of....., 19.....

(COUNTY OFFICIAL)

(DEPUTY)

Form R6-7100-57 (9/71)

FILED July 2 1981
BAKER COUNTY SURVEYOR
SURVEY NO. 7-45-77