


CERTIFIED RECORD OF LAND CORNER MONUMENTATION

M-18

History of original corner establishment:

No previous history.

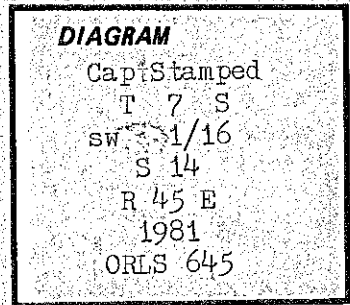

Description of corner evidence found:

None

Description of monument and accessories I established to perpetuate the original location of this corner:

At the 1/16 corner location I set a 2 1/2" brass cap on a 30" galv. iron pipe 2" above the surface of the ground, from which I set two bearing trees:

A Pine 9" dia. bears S 70 15 W, 20.5' horiz. dist. and scribed <sup>SW</sup> 1/16 S S 14 BT.

A Doug. Fir 6" dia. bears S 18 00 E, 59.33' horiz. dist. and scribed <sup>SW</sup> 1/16 S S 14 BT.

I hereby certify the above corner monument was established as herein described during June 1981.

Witnesses:

Mike Cain  
Mike Cain, Inst. Man

Mark L. Cain  
Mark Cain, Chainman

REGISTERED  
PROFESSIONAL  
LAND SURVEYOR

*James H. Hambleton*

OREGON  
JULY 10, 1964  
JAMES H. HAMBLETON  
645

Office of..... County of.....  
State of....., I hereby certify that the within instrument was filed in this office  
for record on the..... day of....., 19.....

(COUNTY OFFICIAL)

(DEPUTY)