


**CERTIFIED RECORD OF LAND CORNER MONUMENTATION**

N-19

**History of original corner establishment:**

Corner was established in 1882 by W. B. Barr, Deputy Surveyor under contract No. 443. Surveyor General's records state: Set basalt rock 13" x 9" x 8", 9" in ground for  $\frac{1}{4}$  Sec. corner marked  $\frac{1}{4}$  on the North side from which:  
 A Pine 18" dia. bears S 73 E, 79 lks. dist. marked  $\frac{1}{4}$  S BT.  
 A Pine 13" dia. bears N 88 W, 175 lks. dist. marked  $\frac{1}{4}$  S BT.

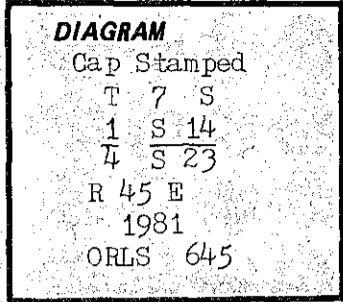

**Description of corner evidence found:**

I found a basalt stone 13" x 9" x 8" with  $\frac{1}{4}$  on the North face from which I also found both bearing trees alive and in good condition.

A Pine 32" dia. (18") with face partly exposed bears S 73 00 E, 52.14' (79 lks.).

A Pine 36" dia. (13") with face healed completely over which bears N 88 00 W, 115.50' (175 lks.).

**Description of monument and accessories I established to perpetuate the original location of this corner:**

I set a 2 $\frac{1}{2}$ " brass cap on a 30" galv. iron pipe 10" below the surface on solid rock. I then placed a large mound of stone 4' dia. at base and 2 $\frac{1}{2}$ ' high covering the monument.

No new bearing trees were set.

REGISTERED  
PROFESSIONAL  
LAND SURVEYOR

*James H. Hambleton*

OREGON  
JULY 10, 1954  
JAMES H. HAMBLETON  
645

I hereby certify the above corner monument was re-established as herein described during May 1981,

Witnesses: *Mike Cain*  
Mike Cain (Inst. Man)

*Mark L. Cain*  
Mark Cain (Chairman)

Office of..... County of.....  
 State of....., I hereby certify that the within instrument was filed in this office  
 for record on the..... day of....., 19.....  
 ..... by .....  
 (COUNTY OFFICIAL) (DEPUTY)

Form R6-7100-57 (9/71)

FILED July 2 1981  
 BAKER COUNTY SURVEYOR  
 SURVEY NO. 7-45-81

★ GPO—798-278