


CERTIFIED RECORD OF LAND CORNER MONUMENTATION

N-21

History of original corner establishment:

Corner was established in 1882 by W. B. Barr, Deputy Surveyor under contract No. 443. Surveyor General's records state: Set ironstone 14" x 12" x 8", 10" in ground for corner to Sec. 13, 14, 23, 24, marked with 1 notch on the East and 3 notches on the South edges from which:
 A Pine 7" dia. bears N 73 E, 68 lks. dist. marked T 7 S R 45 E S 13 BT.
 A Pine 30" dia. bears N 27 W, 75 lks. dist. marked T 7 S R 45 E S 14 BT.
 A Pine 12" dia. bears S 68 W, 200 lks. dist. marked T 7 S R 45 E S 23 BT.
 A Pine 9" dia. bears S 28 E, 228 lks. dist. marked T 7 S R 45 E S 24 BT.

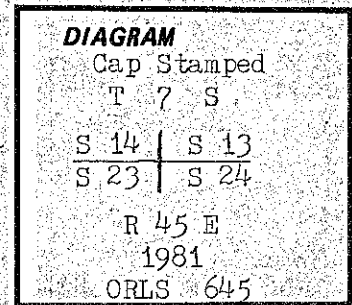

Description of corner evidence found:

Found no trace of original corner, area appeared to have burned a short time after corner was originally set. The area has had good recovery and has been logged in recent years. Thus there is no trace of original corner.

Description of monument and accessories I established to perpetuate the original location of this corner:

I found there is a large discrepancy in the North-South distance between the $\frac{1}{4}$ corner to the South and $\frac{1}{4}$ corner to the North of the section corner. There is no way to determine where that error might have been, thus I determined it necessary to double-proportion this corner location. I then set a 2 $\frac{1}{2}$ " brass cap on a 30" galv. iron pipe, 4" above the surface, from which I set four new bearing trees:

- A Doug. fir 6" dia. bears N 11 00 E, 39.0' horiz. dist. and being scribed, T 7 S R 45 E S 13 BT.
- A Pine 10" dia. bears N 46 30 W, 14.0' horiz. dist. and being scribed, T 7 S R 45 E S 14 BT.
- A Pine 9" dia. bears S 17 00 W, 52.0' horiz. dist. and being scribed, T 7 S R 45 E S 23 BT.
- A Pine 12" dia. bears S 43 30 E, 29.70' horiz. dist. and being scribed T 7 S R 45 E S 24 BT.

REGISTERED
PROFESSIONAL
LAND SURVEYOR

James H. Hambleton

OREGON
JULY 10, 1964
JAMES H. HAMBLETON
645

I hereby certify the above corner monument was re-established as herein described during June 1981.

Witnesses: Mike Cain
Mike Cain, Inst. Man
Mark R. Cain
Mark Cain, Chairman

Office of..... County of.....
 State of..... I hereby certify that the within instrument was filed in this office
 for record on the..... day of....., 19.....
 by.....
 (COUNTY OFFICIAL) (DEPUTY)