


CERTIFIED RECORD OF LAND CORNER MONUMENTATION

0-19

History of original corner establishment:
No previous history.

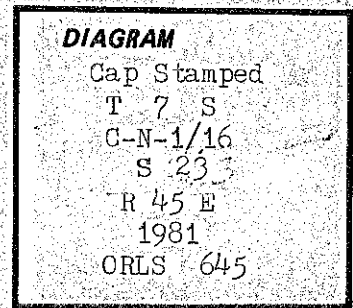

Description of corner evidence found:
None

Description of monument and accessories I established to perpetuate the original location of this corner:

At the 1/16 corner location I set a 2 1/2" brass cap on a 30" galv. iron pipe, 4" above surface of the ground, from which I set two bearing trees:

A Doug. Fir 8" dia. bears N22 30E 40.8' horiz. dist. and scribed ^N 1/16 S 23 BT.

A Doug. fir 8" dia. bears N 45 15 W, 33.5' horiz. dist. and scribed ^N 1/16 S 23 BT.

I hereby certify the above corner monument was established as herein described during June 1981.

REGISTERED
PROFESSIONAL
LAND SURVEYOR

James H. Hambleton

OREGON
JULY 30, 1964
JAMES H. HAMBLETON
645

Witnesses: Mike Cain
Mike Cain, Inst. Man

Mark Cain
Mark Cain, Chainman

Office of..... County of.....
State of..... I hereby certify that the within instrument was filed in this office
for record on the..... day of....., 19.....
..... by

(COUNTY OFFICIAL)

(DEPUTY)