


CERTIFIED RECORD OF LAND CORNER MONUMENTATION

0-21

History of original corner establishment:
No previous history.

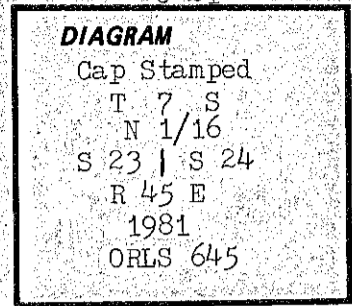

Description of corner evidence found:
None

Description of monument and accessories I established to perpetuate the original location of this corner:

At the 1/16 corner I set a 2½" brass cap on a 30" galv. iron pipe 20" above surface as ground is very rocky. I then placed a large mound of stone about the monument with a base 4' dia. and 20" high covering the monument. I then set two bearing trees.

A Pine 9" dia. bears N 63 00 W, 70.30' horiz. dist. and scribed N 1/16 S 23 BT.

A Pine 13" dia. bears N 27 00 E, 31.90' horiz. dist. and scribed N 1/16 S 24 BT.

REGISTERED
PROFESSIONAL
LAND SURVEYOR

James H. Hambleton

OREGON
JULY 10, 1984
JAMES H. HAMBLETON
645

I hereby certify the above corner monument was established as herein described during May 1981,

Witnesses: *Mike Cain*
Mike Cain (Inst. Man)
Mark Cain
Mark Cain (Chainman)

Office of..... County of.....

State of....., I hereby certify that the within instrument was filed in this office

for record on the..... day of....., 19....

..... by

(COUNTY OFFICIAL)

(DEPUTY)

Form R6-7100-57 (9/71)

FILED July 2, 1981
BAKER COUNTY SURVEYOR
SURVEY NO. 7-45-85