


CERTIFIED RECORD OF LAND CORNER MONUMENTATION

0-24

History of original corner establishment:  
No previous history.

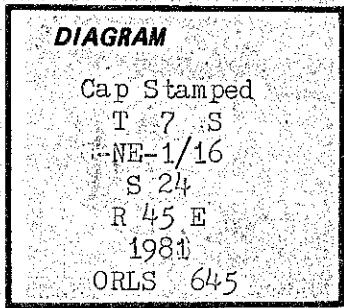

Description of corner evidence found:  
None

Description of monument and accessories I established to perpetuate the original location of this corner:

At the 1/16 corner location I set a 2 1/2" brass cap on a 30" galv. iron pipe 12" above the surface of the ground in a large mound of stone 3 1/2' dia. and 1 1/2' high, from which I set two bearing trees:

A Pine 13" dia. bears N 72 00 W, 49.60' horiz. dist. scribed <sup>NE</sup> 1/16S S24 BT.

A Pine 10" dia. bears S 83 00 W, 35.10' horiz. dist. scribed <sup>NE</sup> 1/16S S24 BT.

I hereby certify the above corner monument was established as herein described during June 1981.

REGISTERED  
PROFESSIONAL  
LAND SURVEYOR

*James H. Hambleton*

OREGON  
JULY 10, 1964  
JAMES H. HAMBLETON  
645

Witnesses: *Mike Cain*  
Mike Cain, Inst. Man  
*Mark L. Cain*  
Mark Cain, Chainman

Office of..... County of.....  
State of..... I hereby certify that the within instrument was filed in this office  
for record on the..... day of....., 19.....  
..... by .....

(COUNTY OFFICIAL)

(DEPUTY)