


CERTIFIED RECORD OF LAND CORNER MONUMENTATION

P-17

History of original corner establishment:

Corner was established in 1882 by W. B. Barr, Deputy Surveyor under contract No. 443. Surveyor General's records state: Set sandstone 11" x 11" x 8", 8 inches in the ground for 1/4 Sec. corner, marked 1/4 on the West-side from which: A Pine 10" in dia. bears N 13 W 128 lks. dist. marked 1/4 S B.T. A Pine 13" in dia. bears N 65 E 26 lks. dist. marked 1/4 S B.T.

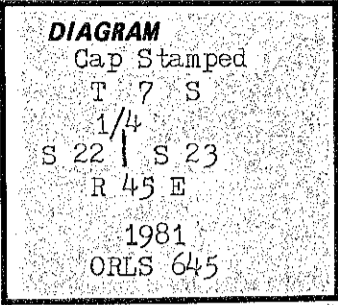

Description of corner evidence found:

I found a 14" x 11" x 7" stone on which were no visible markings. I found a pine snag approx. 20" dia. with face burnt beyond scribing, bears N 65 E, 26 lks. dist. from corner location. I also found evidence of tree rotted wood and stump depression that bears N 13 00 W, 128 lks. from corner. I found 1" iron pipe at fence corner that bears S 54 52 E, 6.60' from corner location.

Description of monument and accessories I established to perpetuate the original location of this corner:

At the assumed 1/4 corner location I set a 2 1/2" brass cap on a 30" galv. iron pipe 6" above the surface in a mound of stone 2 1/2' dia. from which I set two new bearing trees.

A Pine 8" dia. bears S 49 20 W, 20.15' (horiz. dist.) and being scribed 1/4 S S 22 BT.

A Doug. Fir 10" dia. bears N 10 00 E, 44.31' (horiz. dist.) and being scribed 1/4 S S 23 BT.

I hereby certify the above corner monument was re-established as herein described during June 1981.

Witnesses: Mike Cain
Mike Cain, Inst. Man
Mark Cain
Mark Cain, Chairman

REGISTERED
PROFESSIONAL
LAND SURVEYOR

James H. Hambleton

OREGON
JULY 10, 1964
JAMES H. HAMBLETON
645

Office of..... County of.....
State of..... I hereby certify that the within instrument was filed in this office
for record on the..... day of....., 19.....
..... by

(COUNTY OFFICIAL)

(DEPUTY)