


CERTIFIED RECORD OF LAND CORNER MONUMENTATION

P-19

History of original corner establishment:
No previous history.

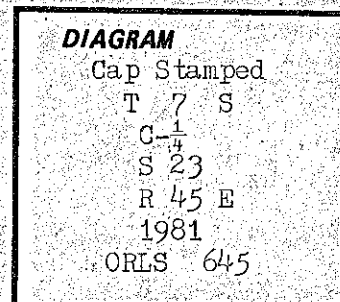

Description of corner evidence found:
None

Description of monument and accessories I established to perpetuate the original location of this corner:

At the 1/4 corner location, which falls in a hay field, I set a 2 1/2" brass cap on a 30" galv. iron pipe 20" below the surface of the ground. I set two bearing trees:

A Pine 32" dia. bears N 73 03 E, 74.30' horiz. distance.

A Pine 37" dia. bears N 16 24 W, 105.42' horiz. distance.

I did not blaze or mark either of these trees as they are on private land.

I hereby certify the above corner monument was established as herein described during June 1981.

REGISTERED PROFESSIONAL LAND SURVEYOR

James H. Hambleton

OREGON
JULY 10, 1964
JAMES H. HAMBLETON
645

Witnesses:

Mike Cain
Mike Cain, Inst. Man

Mark Cain
Mark Cain, Chainman

Office of..... County of.....

State of..... I hereby certify that the within instrument was filed in this office

for record on the..... day of....., 19.....

..... by

(COUNTY OFFICIAL)

(DEPUTY)