


CERTIFIED RECORD OF LAND CORNER MONUMENTATION

P-21

History of original corner establishment:

Corner was established in 1882 by W. B. Barr, Deputy Surveyor under contract No. 443. Surveyor General's records state: Set sandstone 10" x 10" x 8", 7" in the ground for 1/4 Sec. corner, marked 1/4 on the West face from which:

- A Pine 52" dia. bears S 33 E 90 lks. dist. marked 1/4 S BT.
A Pine 40" dia. bears N 66 W 165 lks. dist. marked 1/4 S BT.

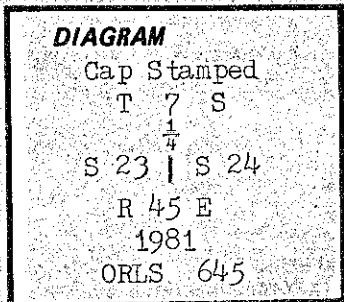

Description of corner evidence found:

At the assumed 1/4 corner location I found no trace of the original corner as described in the GLO notes. However, I found an ancient fence junction that I was able to confirm as being in existence for a minimum of 60 years as I was able to reconstruct the fence line through old stumps that were used as fence post. I counted the growth rings on these old stumps to determine the fence was at least 60 years old. With no other acceptable evidence available I used the existing fence corner as the actual 1/4 corner.

Description of monument and accessories I established to perpetuate the original location of this corner:

At the 1/4 corner location I set a 2 1/2" brass cap on a 30" galv. iron pipe 2" above the surface of the ground, from which I set one bearing tree:

- A Pine
A Pine 35" dia. bears N 09 00 W, 31.49' horiz. dist. with no markings as the tree is in private land.

I hereby certify the above corner monument was re-established as herein described during June 1981.

Witnesses: Mike Cain, Inst. Man; Mark Cain, Chainman

REGISTERED PROFESSIONAL LAND SURVEYOR

[Handwritten signature]

OREGON JULY 10, 1964 JAMES H. HAMBLETON 645

Office of... County of... State of... I hereby certify that the within instrument was filed in this office for record on the... day of... 19... (COUNTY OFFICIAL) (DEPUTY)