


CERTIFIED RECORD OF LAND CORNER MONUMENTATION

P-25

History of original corner establishment:

Corner was established in 1882 by W. B. Barr, Deputy Surveyor under contract No. 443. Surveyor General's records state: Set volcanic rock 12" x 10" x 9", 8" in ground for 1/4 sec. corner marked 1/4 on the West-side from which a Quaking-aspen 3" dia. bears S 4 E, 90 lks. dist. marked 1/4 S BT. A Quaking-aspen 5" dia. bears S 10 W, 87 lks. dis. marked 1/4 S BT.

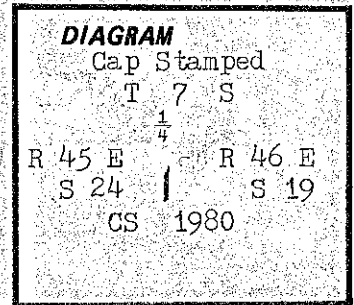

Description of corner evidence found:

At the assumed 1/4 corner location I found an ancient fence corner with a small rock jack in a thorn bush. Also I found a brass cap in a newer fence corner and mound of stonewhich bears west 10' from the ancient corner. No other evidence available.

Description of monument and accessories I established to perpetuate the original location of this corner:

Using the brass cap 1/4 corner of which there were no bearing trees set previously, I then set one new bearing tree and one bearing object.

For Section 24 I used a Basalt stone 32" x 24" and unknown depth in ground as a bearing object which bears N 58 W, 22.50' horiz. dist. marked with an X on the high point and B.O. facing the corner.

A Pine 15" dia. bears N 80 E, 71.75' horiz. dist. and scribed 1/4 S S 19 BT.

I hereby certify the above corner monument was re-established as herein described during June 1981.

REGISTERED PROFESSIONAL LAND SURVEYOR

*James H. Hambleton*

OREGON  
JULY 10, 1954  
JAMES H. HAMBLETON  
645

Witnesses: Mike Cain  
Mike Cain, Inst. Man  
Mark L. Cain  
Mark Cain, Chainman

Office of..... County of.....  
State of....., I hereby certify that the within instrument was filed in this office  
for record on the..... day of....., 19.....  
..... by .....

(COUNTY OFFICIAL)

(DEPUTY)