


CERTIFIED RECORD OF LAND CORNER MONUMENTATION

R-17

History of original corner establishment:

Corner was established in 1882 by W. B. Barr, Deputy surveyor under contract No. 443. Surveyor General's records state: Set iron rock 14" x 10" x 9", 10" in ground, mkd. with 2 notches on the east and 2 notches on South edges from which:
 A pine 18" dia. bears N 12 E, 11 lks. dist. mkd. T 7 S R 45 E S 23 BT.
 A pine 20" dia. bears N 88 W, 63 lks. dist. mkd. T 7 S R 45 E S 22 BT.
 A pine 24" dia. bears S 49 W, 32 lks. dist. mkd. T 7 S R 45 E S 27 BT.
 A pine 12" dia. bears S 75 E, 19 lks. dist. mkd. T 7 S R 45 E S 26 BT.

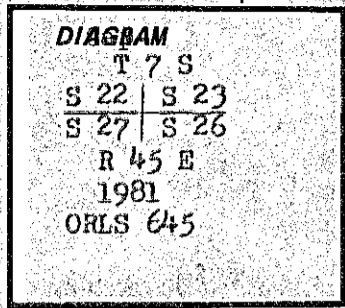

Description of corner evidence found:

At the assumed corner location found no evidence of the original corner stone as it was destroyed when a ditch was built over the corner.
 Found alive 36" pine bears N 18 E, 7.26' (N 12 E, 11 lks.) mkd. T 7 S R 45 E S 23 BT.
 Found stump hole of a pine 20" dia. bears N 88 W, 41.58' (63 lks.).
 Found a burnt pine stump approx. 28" dia. in poor condition with no scribing which bears S 49 W, 21.12' (32 lks.).
 Found live 32" pine bears S 74 E, 12.54' (S 75 E, 19 lks.) mkd. T 7 S R 45 E S 26 BT.

Description of monument and accessories established to perpetuate the original location of this corner:

At the section corner location I set a 2 1/2" brass cap on a 30" galv. iron pipe 10" below the bottom of the ditch.
 Set two new BT's:
 A 6" ponderosa pine bears N 77 30 W, 27.50' mkd. T 7 S R 45 E S 22 BT.
 A 5" ponderosa pine bears S 54 00 W, 34.75' mkd. T 7 S R 45 E, S 27 BT.

REGISTERED
PROFESSIONAL
LAND SURVEYOR

James H. Hambleton

OREGON
JULY 10, 1964
JAMES H. HAMBLETON
645

I hereby certify the above corner monument was re-established as herein described during June 1981.

Witnesses:

Mike Cain
Mike Cain, Inst. Man
Mark R. Cain
Mark Cain, Chairman

Office of..... County of.....
 State of..... I hereby certify that the within instrument was filed in this office
 for record on the..... day of....., 19.....
 by
 (COUNTY OFFICIAL) (DEPUTY)