


**CERTIFIED RECORD OF LAND CORNER MONUMENTATION**

R-21

**History of original corner establishment:**

Corner was established in 1882 by W. B. Barr, Deputy Surveyor under contract No. 443. Surveyor General's records state: Set post 4' long, 4" dia., 24" in the ground for corner to Sec. 23, 24, 25, 26 marked T 7 S S 24 on the NE face R 45 E S 25 on the SE face. S 26 on the SW face and Sec. 23 on the NW face with 2 notches on the South and 1 notch on the East edges from which:  
 A Pine 20" dia. bears N 46 E 15 lks. dist. marked T 7 S R 45 E S 24 BT.  
 A Pine 38" dia. bears S 57 E 80 lks. dist. marked T 7 S R 45 E S 25 BT.  
 A Pine 8" dia. bears S 87 W 68 lks. dist. marked T 7 S R 45 E S 26 BT.  
 A Pine 8" dia. bears N 63 W 113 lks. dist. marked T 7 S R 45 E S 23 BT.

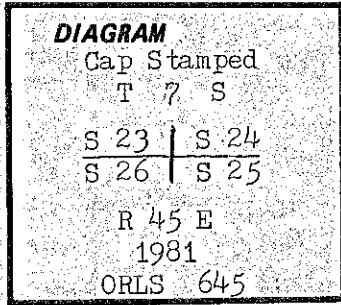

**Description of corner evidence found:**

At the assumed corner location I found no evidence of the original corner as described in the GLO notes. I found a granite stone 15" x 13" x 4" set upright at an old existing fence junction. Stone is marked with 4 notches on the north, 2 notches on the south and 1 notch on the east faces, with an X chiseled on the top. Stone had previously, in 1965, been described to me by the late Walter Blacker now deceased, but being a resident in the Pine Valley near the townsite of Carson for most of his life.

**Description of monument and accessories I established to perpetuate the original location of this corner:**

At the section corner location I set a 2 1/2" brass cap on a 30" galv. iron pipe flush with the surface of the ground. I buried the stone upside down and along the west edge of the monument. There were no bearing trees available.

I hereby certify the above corner monument was re-established as herein described during June 1981.

Witnesses: Mike Cain  
 Mike Cain, Inst. Man  
Mark L. Cain  
 Mark Cain, Chairman

REGISTERED  
 PROFESSIONAL  
 LAND SURVEYOR

*James H. Hambleton*

OREGON  
 JULY 10, 1954  
 JAMES H. HAMBLETON  
 645

Office of..... County of.....  
 State of....., I hereby certify that the within instrument was filed in this office  
 for record on the..... day of....., 19.....  
 ..... by .....  
 (COUNTY OFFICIAL) (DEPUTY)