


CERTIFIED RECORD OF LAND CORNER MONUMENTATION

R-23

History of original corner establishment:

Corner was established in 1882 by W. B. Barr, Deputy surveyor under contract No. 443. Surveyor General's records state: Set volcanic rock 14" x 12" x 8", 10" in ground for $\frac{1}{4}$ Sec. corner marked $\frac{1}{4}$ on the North side raised mound of rock alongside; Pits impracticable,

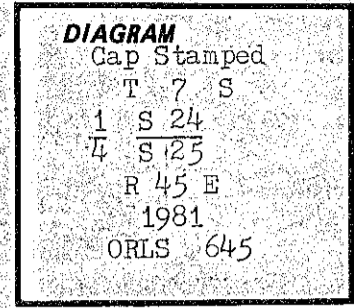

Description of corner evidence found:

At the assumed $\frac{1}{4}$ corner location I found no evidence of original stone as described in the GLO notes. However, I found an old existing fence line running East and West that appears, due to the growth of trees and brush along the line, to be at least 60 to 80 years old. Also I found traces of an old fence that cornered with the East-West fence line and ran in a southerly direction. By reconstructing the corner position it checked with the adjacent found corner. Therefore, I accepted the location as being the original $\frac{1}{4}$ corner location.

Description of monument and accessories I established to perpetuate the original location of this corner:

At the $\frac{1}{4}$ corner location I set a $2\frac{1}{2}$ " brass cap on a 30" galv. iron pipe, 2" above the surface of the ground in the East-West fence line at the fence corner intersection. I located a Pine 24" dia. which bears S 01 30 E, 28.7' horiz. dist., but did not mark due to being situated on private land.

I hereby certify the above corner monument was re-established as herein described during June 1981.

Witnesses:

Mike Cain
Mike Cain, Inst. Man

Mark Cain
Mark Cain, Chairman

REGISTERED
PROFESSIONAL
LAND SURVEYOR

James H. Hambleton

OREGON
JULY 10, 1964
JAMES H. HAMBLETON
645

Office of..... County of.....

State of..... I hereby certify that the within instrument was filed in this office for record on the..... day of....., 19.....

..... by
(COUNTY OFFICIAL) (DEPUTY)