


REPORT

CORNER SEARCH, EVALUATION, MONUMENTING and BOUNDARY MARKING

From _____ To _____

Region _____ Forest _____

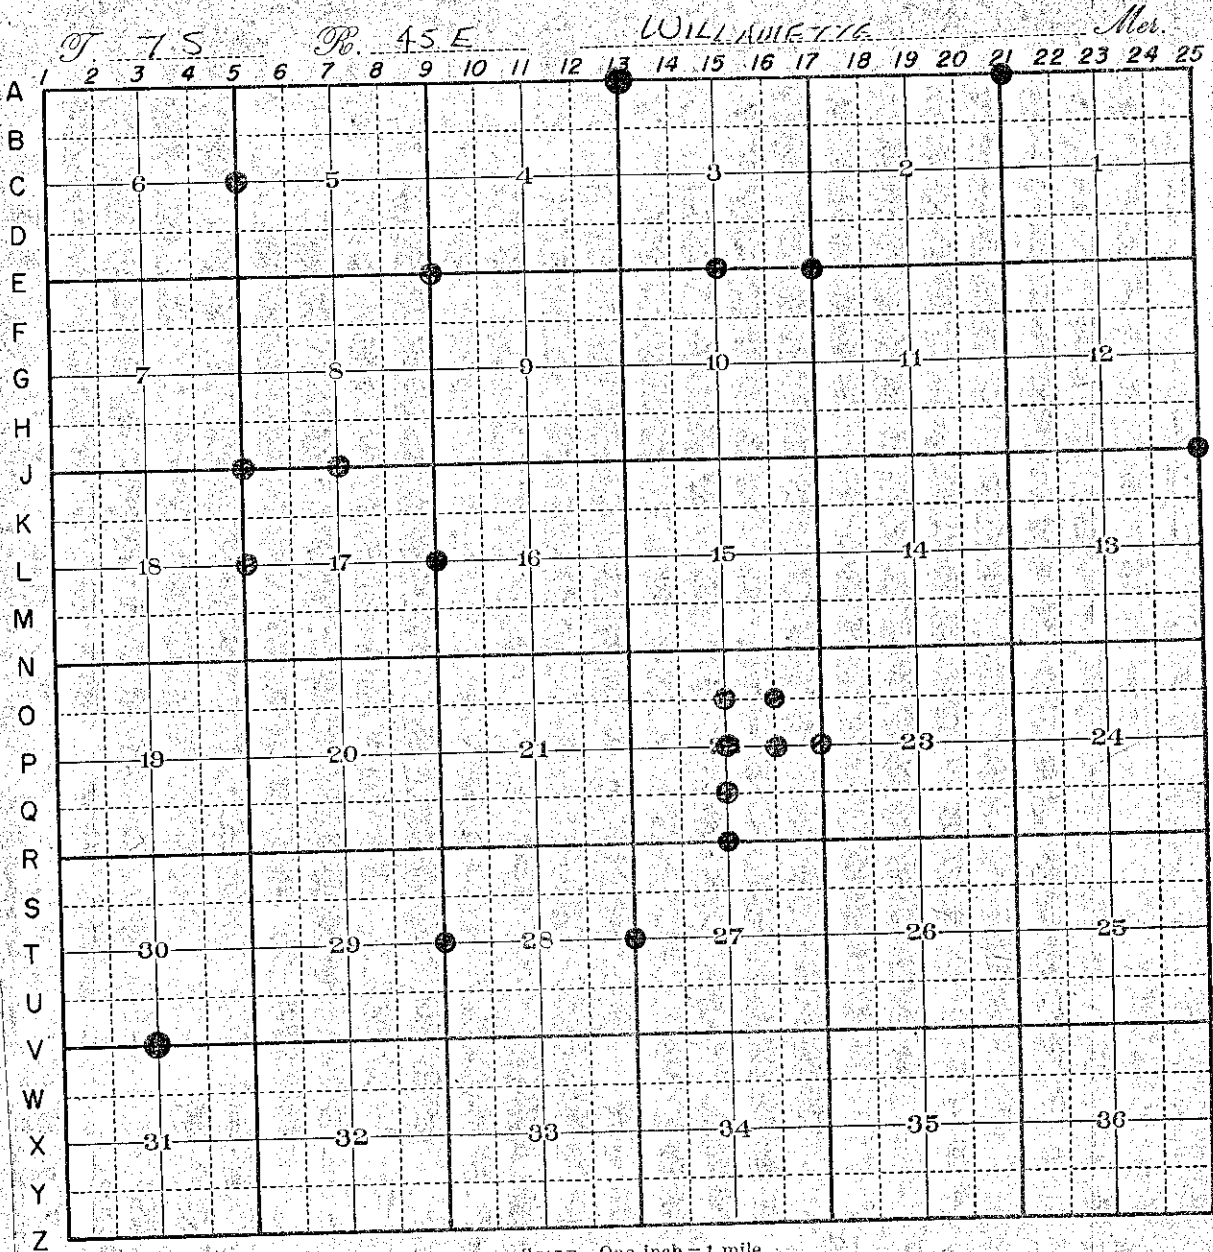

LEGEND

- Corners searched for
- Corners monumented
- ⊗ Evidence believed acceptable
- Boundary posted (line only in red)

FILED Sept 16 1983
BAKER COUNTY SURVEYOR
SURVEY NO. 7-45-99

7100-53