


CERTIFIED RECORD OF LAND CORNER MONUMENTATION

History of original corner establishment:

Corner originally established by W.B. Barr under GLO contract No 443, dated May 29, 1882. Surveyor General record states:
 Set basalt rock 14x10x8 ins 10 inches in ground for 1/4 Sec corner marked 1/4 on the North side from which;
 A pine 15 in diam bears S18°W 220 lks dist marked 1/4 S BT
 A pine 16 in diam bears N72°W 204 lks dist marked 1/4 S BT
 Corner remonumented by A. Joseph Garrison for the BLM under U.S. Survey Group No. 350, dated June 16, 1975. Official record states in part;

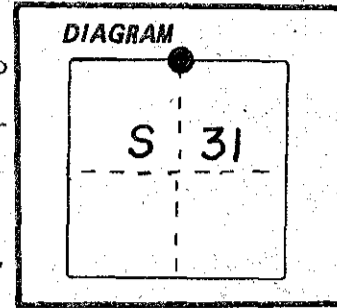

Found stone call size firmly set in mound of stone and remains of original BTs.
 At the corner point set iron post with brass cap from which new bearing trees:

A pine 8 ins diam bears N44°E 28 lks dist marked 1/4 S30 BT
 A pine 10 ins diam bears S51 1/2°E 24 lks dist marked 1/4 S31 BT

Description of corner evidence found:

Found standard BLM brass cap marked as shown below

Found North BT now a 8 in dia pine N44°E, 28 lks, scribes visible, live and vigorous

Found 10 in diam pine snag S51 1/2°E, 24 lks scribes visible

Description of monument and accessories I established to perpetuate the original location of this corner:

From the above described monument:

NEW BT

A 12 in diam pine bears West, 24.0 feet marked 1/4 S31 BT

Set steel fence post approximately 5 feet West with 54-4 sign


Corner updated August 8, 1982
 Witness: Rick Robinson

I hereby certify this corner was re-established as hereon described on the date written above

REGISTERED
 PROFESSIONAL
 LAND SURVEYOR

Handwritten signature of Duane I. Griffith

OREGON
 JULY 10, 1964
 DUANE I. GRIFFITH
 644

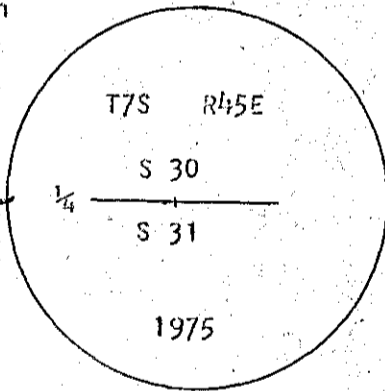

I used a steel tape and magnetic compass in the establishment of accessories. I used 20° East magnetic declination, and distance to the new BT is to the center of the tree. I placed a brass washer marked OPLS 644 by the BT blaze on the new BT.

Office of..... County of.....
 State of....., I hereby certify that the within instrument was filed in this office
 for record on the..... day of....., 19.....
 by
 (COUNTY OFFICIAL) (DEPUTY)

Form R6-7100-57 (9/71)

FILED 7-16-83
 BAKER COUNTY SURVEYOR
 SURVEY NO. 7-45-100

☆ GPO—798-276

