


**CERTIFIED RECORD OF LAND CORNER MONUMENTATION**

History of original corner establishment:  
 Corner originally established by W.B. Barr under GLO Contract No 443, dated May 29, 1882. Surveyor General record states:  
 Set post 4 ft long 4 in diam 24 inches in ground for 1/4 Sec corner marked 1/4 S on the West side from which, a tamarack 16 in diam bears N15° W, 19 lks dist marked 1/4 S BT  
 A fir 12 in diam bears N76° E, 26 lks dist marked 1/4 S BT

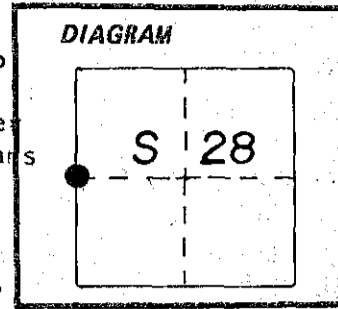

Corner remonumented by A. Joseph Garrison for the BLM under U.S. Survey/Group No. 350, dated June 16, 1975. Official record states in part: Corner position determined from record bearing and distance from the remains of the original Bearing trees:  
 A white fir 28 ins diam bears N76° E, 26 lks dist, scribes visible  
 Set iron post with brass cap for corner from which:  
 new BT A pine 19 ins diam bears S83 1/4° W, 78 lks dist marked 1/4 S29 BT

**Description of corner evidence found:**

- Found standard BLM brass cap marked as shown below
- Found original BT, now a 24 in diam white fir N79° E, 17.5 feet, chopped out.
- Found BLM BT, top blown out, now a 18 in diam pine snag, scribes visible, record bearing and distance

**Description of monument and accessories I established to perpetuate the original location of this corner:**

From the above described monument:

**NEW BTs**

- A 16 in diam white fir bears N10° W, 38.0 feet, marked 1/4 S29 BT
- A 12 in diam white fir bears S83° E, 37.8 feet, marked 1/4 S28 BT

Set a steel fence post approximately 5 feet North with 54-4 sign attached

Corner updated August 28, 1982

Witness: Rick Robinson


**I hereby certify this corner was re-established as hereon described on the date written above**

I used a steel tape and magnetic compass in the establishment of accessories. I used 20° East magnetic declination, and distance to the new BT is to the center of the tree. I placed a brass washer marked OPLS 644 by the BT blaze on the new BT.

REGISTERED  
PROFESSIONAL  
LAND SURVEYOR

*Duane I. Griffith*

OREGON  
JULY 10, 1964  
DUANE I. GRIFFITH  
644

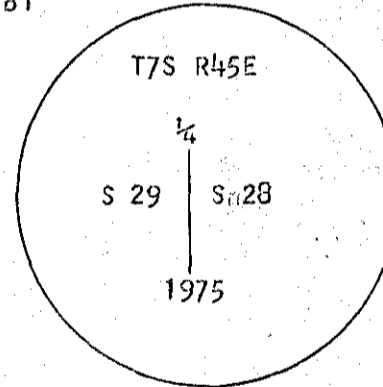

Office of..... County of.....  
 State of....., I hereby certify that the within instrument was filed in this office for record on the..... day of....., 19.....  
 ..... by .....  
 (COUNTY OFFICIAL) (DEPUTY)

Form R6-7100-57 (9/71)

FILED Sept 16, 1983  
 BAKER COUNTY SURVEYOR  
 SURVEY NO. 7-45-101

☆ GPO-798-276

2