


CERTIFIED RECORD OF LAND CORNER MONUMENTATION

History of original corner establishment:

Corner originally established by W.B. Barr under GLO contract NO. 443, dated May 29, 1882. Surveyor General record states:

Set basalt rock 14x10x8 ins 10 inches in ground for 1/4 Sec corner marked 1/4 on the West side from which
 A fir 6 in diam bears N5°E 57 lks dist marked 1/4S BT
 A fir 12 in diam bears N50°W, 82 lks dist marked 1/4S BT

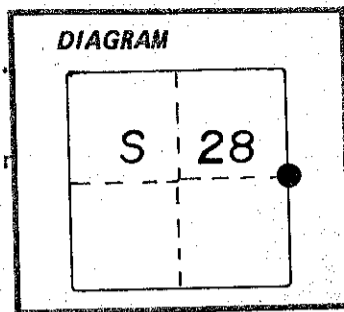

Corner remonumented in September, 1969 by James Hanley. Record states in part:

Found original stone and both original BTs live and vigorous. Set iron pipe with aluminum cap.

Description of corner evidence found:

Found 1" diam iron pipe with 2" aluminum cap marked as shown below.

Found original Northeast BT, N2°E, 40.6 feet to center of tree, live and vigorous

Description of monument and accessories I established to perpetuate the original location of this corner:

From the above described monument:

NEW BTs

A 12 in diam double bole P.Pine bears S10°W, 46.0 feet marked 1/4 S28 BT

Set steel fence post approximately 5 feet West with 54-4 sign attached

Corner updated November 22, 1981

Witnesses: Greg Blackman and Rick Robinson


I hereby certify this corner was re-established as hereon described on the date written above

I used a steel tape and magnetic compass in the establishment of accessories. I used 20° East magnetic declination, and distance to the new BT is to the center of the tree. I placed a brass washer marked OPLS 644 by the BT blaze on the new BT.

**REGISTERED
PROFESSIONAL
LAND SURVEYOR**



OREGON
JULY 10, 1964
DUANE I. GRIFFITH
644

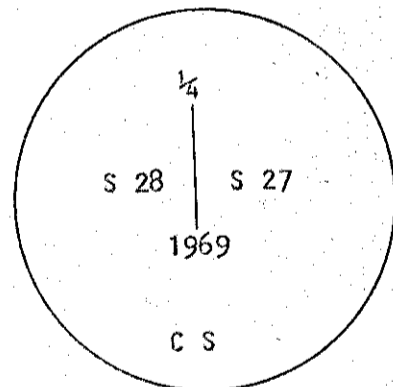

Office of..... County of.....
 State of....., I hereby certify that the within instrument was filed in this office
 for record on the..... day of....., 19.....
 by
 (COUNTY OFFICIAL) (DEPUTY)