


CERTIFIED RECORD OF LAND CORNER MONUMENTATION

History of original corner establishment:

Corner originally established by W.B. Barr under GLO contract No. 443, dated May 29, 1882. Surveyor General record states;

Set iron rock 17x10x6 ins. 12 inches in the ground for corner to 1/4 Sec. marked 1/4 on the North side from which:

A fir 14 in diam bears S38°E 22 lks dist marked 1/4 SBT
A fir 6 in diam bears N73°W 40 lks dist marked 1/4 SBT

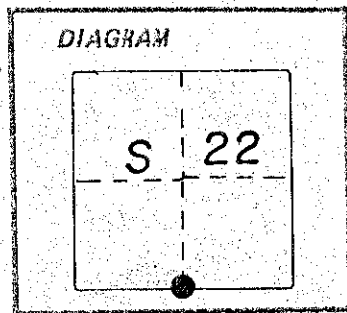

Description of corner evidence found:

NONE

Description of monument and accessories I established to perpetuate the original location of this corner:

At proportionate distance, I set a 2 1/2" x 30" iron pipe with brass cap marked as shown, 30 inches in the ground, from which:


A 22" dia. P.Pine bears N46°E, 52.1 feet, marked 1/4 S22 BT

A 30" dia. Red fir bears S22°E, 36.0 feet, marked 1/4 S27 BT

Set steel fence post approximately 4 feet West, with 54-4 sign attached

Corner set November 18, 1981

Witnesses: Greg Blackman and Rick Robinson
See survey dated December, 1982

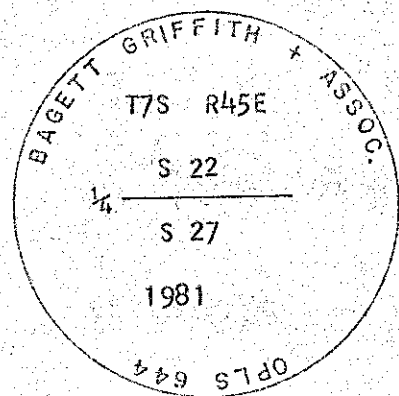

REGISTERED
PROFESSIONAL
LAND SURVEYOR

OREGON
JULY 10, 1964
DUANE I. GRIFFITH
644

I hereby certify this corner was re-established as hereon described on the date written above

I used a steel tape and magnetic compass in the establishment of accessories. I used 20° East magnetic declination, and distances to the new BTs are to the center of the tree. I placed a brass washer marked OPLS 644 by the BT blaze of new BTs.

Office of..... County of.....
State of....., I hereby certify that the within instrument was filed in this office for record on the..... day of....., 19.....
..... by
(COUNTY OFFICIAL) (DEPUTY)

Form R6-7100-57 (9/71)

FILED Sept 16, 1983
BAKER COUNTY SURVEYOR
SURVEY NO. 7-45-104

GPO-793-279

5 ✓