


CERTIFIED RECORD OF LAND CORNER MONUMENTATION

History of original corner establishment:  
Corner not previously established

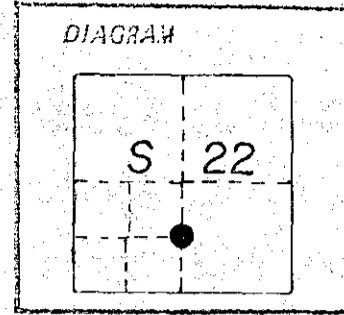

Description of corner evidence found:  
NONE

Description of monument and accessories I established to perpetuate the original location of this corner:

At corner position I set a 2 1/2" x 30" aluminum pipe with aluminum cap marked as shown 30 inches in the ground from which:


- A 10 in diam white fir bears N12°E, 50.4 feet marked X BT
- A 12 in diam white fir bears N47°W, 38.7 feet marked CS 1/16 S22 BT

Set steel fence post approximately 5 feet Northerly with 54-2 and 54-9 sign attached

Corner set October 16, 1982

Witnesses: Greg Blackman, Rick Robinson and Ray Crapo

See survey dated December, 1982

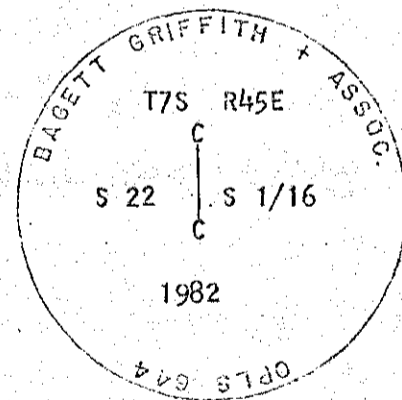

REGISTERED PROFESSIONAL LAND SURVEYOR

*Quane I. Griffith*

OREGON JULY 19, 1964  
DUANE I. GRIFFITH  
644

I hereby certify this corner was re-established as hereon described on the date written above

I used a steel tape and magnetic compass in the establishment of accessories. I used 20° East magnetic declination, and distances to the new BTs are to the center of the tree. I placed a brass washer marked OPLS 644 by the BT blaze of new BTs.

Office of..... County of.....

State of..... I hereby certify that the within instrument was filed in this office for record on the..... day of....., 19.....

..... by .....  
(COUNTY OFFICIAL) (DEPUTY)

Form RS-7100-57 (9/71)

FILED Sept 16 1983  
BAKER COUNTY SURVEYOR  
SURVEY NO. 7-45-105

6