


CERTIFIED RECORD OF LAND CORNER MONUMENTATION

History of original corner establishment:
Corner not previously established

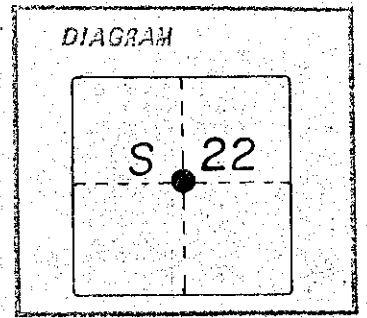

Description of corner evidence found:

NONE

Description of monument and accessories I established to perpetuate the original location of this corner:

At corner position I set a 2 1/2"x30" aluminum pipe with aluminum cap marked as shown 30 inches in the ground from which:


- A 16 in diam pine bears S27°E, 68.8 feet marked C 1/4 S22 BT
- A 10 in diam white fir bears N3°W, 65.9 feet marked C 1/4 S22 BT

Set steel fence post approximately 5 feet Westerly with 54-2 sign and approximately 5 feet Southerly with 54-2 and 54-9 sign attached

Corner set October 16, 1982

Witnesses: Greg Blackman, Rick Robinson and Ray Crapo

See survey dated December, 1982

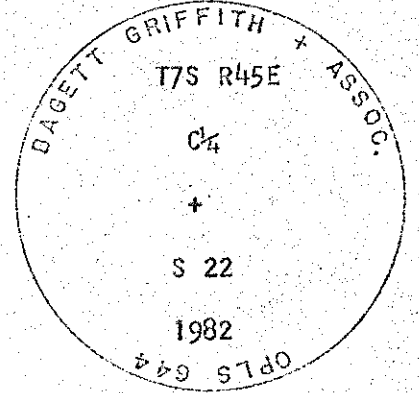

REGISTERED
PROFESSIONAL
LAND SURVEYOR

I hereby certify this corner was re-established as hereon described on the date written above

OREGON
JULY 19, 1964
DUANE I. GRIFFITH
644

I used a steel tape and magnetic compass in the establishment of accessories. I used 20° East magnetic declination, and distances to the new BTs are to the center of the tree. I placed a brass washer marked OPLS 644 by the BT blaze of new BTs.

Office of..... County of.....

State of....., I hereby certify that the within instrument was filed in this office for record on the..... day of....., 19.....

..... by
(COUNTY OFFICIAL) (DEPUTY)