


CERTIFIED RECORD OF LAND CORNER MONUMENTATION

History of original corner establishment:  
Corner not previously established

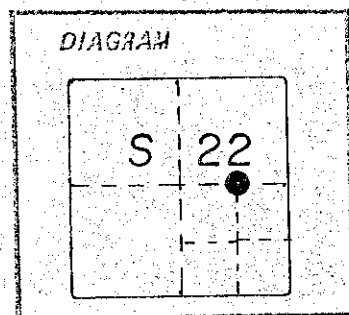

Description of corner evidence found:  
NONE

Description of monument and accessories established to perpetuate the original location of this corner:

At corner position I set a 2 1/2" x 30" aluminum pipe with aluminum cap marked as shown 30 inches in the ground, from which:


- A 12 in diam P.Pine bears N70°E 30.0 feet marked CE 1/16 S22 BT
- A 13 in diam P.Pine bears N84°E 32.9 feet marked X BT

Set steel fence post approximately 5 feet Northerly with 54-2 and 54-9 sign and approximately 5 feet Easterly with 54-2 sign attached

Corner set October 14, 1982

See survey dated December, 1982

I heraby certify this corner was re-established as hereon described on the date written above

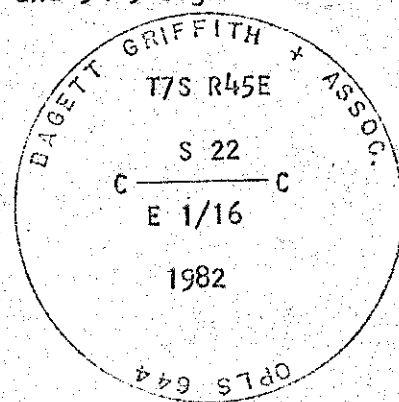

REGISTERED PROFESSIONAL LAND SURVEYOR

*Duane I. Griffith*

OREGON JULY 19, 1964 DUANE I. GRIFFITH 644

I used a steel tape and magnetic compass in the establishment of accessories. I used 20° East magnetic declination, and distances to the new BTs are to the center of the tree. I placed a brass washer marked OPLS 544 by the BT blaze of new BTs.

Office of..... County of.....  
State of....., I hereby certify that the within instrument was filed in this office for record on the..... day of....., 19.....

..... by .....  
(COUNTY OFFICIAL) (DEPUTY)