


CERTIFIED RECORD OF LAND CORNER MONUMENTATION

History of original corner establishment:

Corner originally established by W.B. Barr under GLO contract No. 443, dated May 29, 1882. Surveyor General record states;
 Set sandstone 11x11x8 ins, 8 inches in ground for 1/4 Sec corner marked 1/4 on the West side from which:
 A pine 10 in diam bears N13W 128 lks dist marked 1/4 S BT
 A pine 13 in diam bears N65E 26 lks dist marked 1/4 S BT

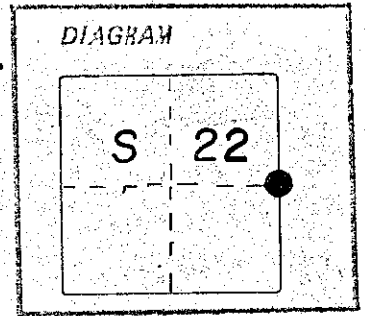

Corner remonumented by unrecorded survey by Ira L. Hoffman, Baker County Surveyor, dated April 1928. Record states:

Found marked stone and 2 bearing trees for East 1/4 corner. Set a 1"x4" pipe in mound of stone

Description of corner evidence found:

Found 1 inch diameter pipe in mound of stone and in fence corner

Found brass cap set by James H. Hambleton, found to be unacceptable

Description of monument and accessories established to perpetuate the original location of this corner:

In place of pipe, I set a 2 1/2"x30" aluminum pipe with aluminum cap marked as shown, 26 inches in the ground from which:


NEW BTs

A 12 in dia red fir bears S34°E 50.0 feet marked 1/4 S23 BT
 A 10 in dia pine bears S41°W 35.5 feet marked 1/4 S22 BT

Raised mound of stone around monument pipe is Southeasterly and adjacent to monument
 Set steel fence post approximately 5 feet Westerly with 54-4 and 54-2 signs attached
 Hambleton's brass cap bears N58°34'45"W, 6.55 feet from the true corner position

Corner set October 14, 1982

Witnesses: Greg Blackman, Rick Robinson and Ray Crapo
 See survey dated December, 1982

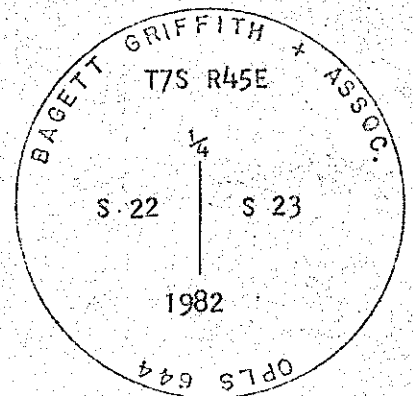

I hereby certify this corner was re-established as hereon described on the date written above

I used a steel tape and magnetic compass in the establishment of accessories. I used 20° East magnetic declination, and distances to the new BTs are to the center of the tree. I placed a brass washer marked OPLS 644 by the BT blaze of new BTs.

REGISTERED
 PROFESSIONAL
 LAND SURVEYOR

Duane F. Griffith

OREGON
 JULY 10, 1964
 DUANE F. GRIFFITH
 644

Office of..... County of.....

State of....., I hereby certify that the within instrument was filed in this office for record on the..... day of....., 19.....

..... by
 (COUNTY OFFICIAL) (DEPUTY)