


CERTIFIED RECORD OF LAND CORNER MONUMENTATION

History of original corner establishment:
Corner not previously established

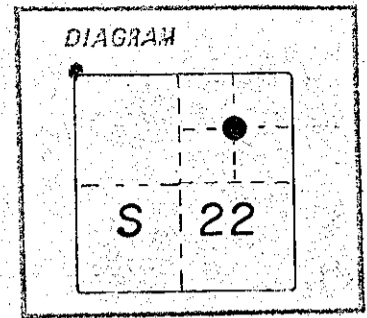

Description of corner evidence found:
NONE

Description of monument and accessories I established to perpetuate the original location of this corner:


The corner position falls on an old stump and is impracticable to set, therefore I set a witness corner 9.00 feet Southerly on the 1/16 line. I set a 2 1/2" x 30" aluminum pipe with aluminum cap marked as shown 27 inches in the ground, from which:

- A 18 in diam pine bears N70E 6.7 feet marked X BT
- A 12 in diam red fir bears S280W 79.1 feet marked X BT

Set a steel post at approximately the corner position with 54-2 sign and approximately 5 feet Southerly of the witness corner with 54-2 and 54-9 sign attached

Corner set October 14, 1982

See survey dated December, 1982

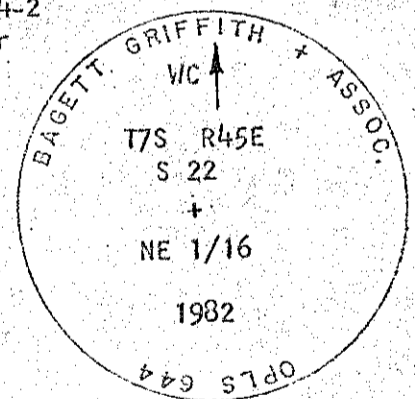

I hereby certify this corner was re-established as hereon described on the date written above

I used a steel tape and magnetic compass in the establishment of accessories. I used 20° East magnetic declination, and distances to the new BTs are to the center of the tree. I placed a brass washer marked OPLS 644 by the BT blaze of new BTs.

REGISTERED PROFESSIONAL LAND SURVEYOR

Duane I. Griffith

OREGON
JULY 10, 1964
DUANE I. GRIFFITH
644

Office of..... County of.....
State of..... I hereby certify that the within instrument was filed in this office
for record on the..... day of....., 19.....
..... by.....
(COUNTY OFFICIAL) (DEPUTY)

Form R6-7100-57 (9/71)

FILED Sept 16 1983
BAKER COUNTY SURVEYOR
SURVEY NO. 7-45-109