


CERTIFIED RECORD OF LAND CORNER MONUMENTATION

History of original corner establishment:

Corner not previously established

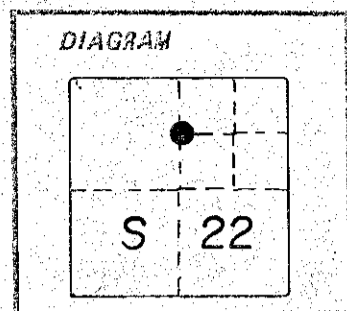

Description of corner evidence found:

NONE

Description of monument and accessories I established to perpetuate the original location of this corner:

At corner position, I set a 2 1/2" x 30" aluminum pipe with aluminum cap marked as shown, 27 inches in the ground from which:


- A 14 in diam P.Pine bears N10°W, 65.1 feet marked CN1/16 S22 BT
- A 9 in diam red fir bears S47°E, 16.2 feet marked CN1/16 S22 BT

Raised mound of stone around monument

Set steel fence post approximately 5 feet Northerly with 54-2 sign and approximately 5 feet Easterly with 54-2 and 54-9 sign attached

Corner set October 14, 1982

See survey dated December, 1982

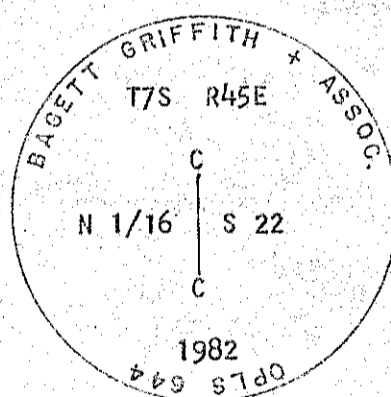

REGISTERED PROFESSIONAL LAND SURVEYOR

Handwritten signature of Duane I. Griffith

OREGON JULY 10, 1964 DUANE I. GRIFFITH 644

I hereby certify this corner was re-established as hereon described on the date written above

I used a steel tape and magnetic compass in the establishment of accessories. I used 20° East magnetic declination, and distances to the new BTs are to the center of the tree. I placed a brass washer marked OPLS 644 by the BT blaze of new BTs.

Office of..... County of..... State of....., I hereby certify that the within instrument was filed in this office for record on the..... day of....., 19..... by..... (COUNTY OFFICIAL) (DEPUTY)

Form R6-7100-57 (9/71)

FILED Sept 16 1983 BAKER COUNTY SURVEYOR SURVEY NO. 7-45-110

6-645-133-236

