


CERTIFIED RECORD OF LAND CORNER MONUMENTATION

History of original corner establishment:
Corner originally established by W.B. Barr under GLO contract No. 443, dated May 29, 1882. Surveyor General record states:

Set volcanic rock 12x12x8 ins 8 inches in the ground for 1/4 Sec corner, marked 1/4 on the West side from which:

A tamarack 16 in diam bears N55°W 18 lks dist marked 1/4S BT

A fir 5 ins diam bears N59°E, 20 lks dist marked 1/4S BT

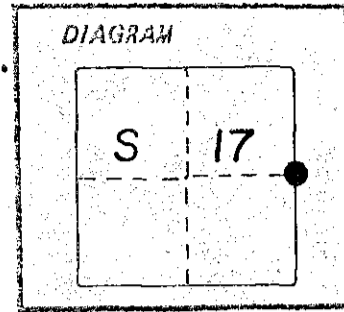

Description of corner evidence found:

Found marked stone, call size in small mound of stone

Found 11 inch diam white fir N57°E 13.3 feet to face of blaze, tree live and vigorous, did not open

Found a 17 inch diameter tamarack N30°W, 11.9 feet, dead and down, scribes visible

REGISTERED
PROFESSIONAL
LAND SURVEYOR

Duane I. Griffith

OREGON
JULY 10, 1964
DUANE I. GRIFFITH
644

Description of monument and accessories I established to perpetuate the original location of this corner:

In place of stone I set a 2 1/2" X 30" iron pipe with brass cap marked as shown 28 inches in the ground from which:

NEW BT

A 27 inch diam pine bears N25°W 93.1 feet marked 1/4 S17 BT

Set a steel fence post approximately 4 feet North with 54-4 sign attached

Corner set November 20, 1981


Witnesses: Greg Blackman and Rick Robinson

Buried stone North and alongside of monument

Raised mound of stone around monument

I hereby certify this corner was re-established as hereon described on the date written above

I used a steel tape and magnetic compass in the establishment of accessories. I used 20° East magnetic declination, and distances to the new BTs are to the center of the tree. I placed a brass washer marked OPLS 644 by the BT blaze of new BTs.

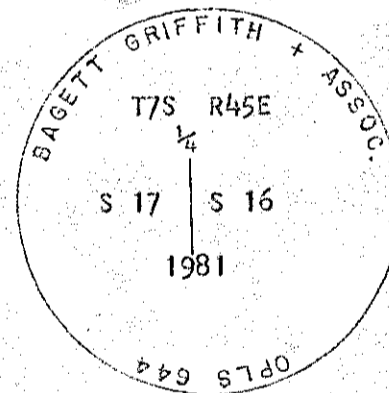

Office of..... County of.....
State of..... I hereby certify that the within instrument was filed in this office
for record on the..... day of....., 19.....
..... by
(COUNTY OFFICIAL) (DEPUTY)

Form R6-7100-57 (9/71)

FILED Sept 16 1983
BAKER COUNTY SURVEYOR
SURVEY NO. 7-45-111

☆ GPO-773-179

12