


CERTIFIED RECORD OF LAND CORNER MONUMENTATION

History of original corner establishment:  
 Corner originally established by W.B. Barr under GLO contract No. 443, dated May 29, 1882. Surveyor General record states;  
 Set basalt rock 14x10x6 ins 10 inches in ground for 1/4 Sec corner marked 1/4 on the West side, from which,  
 A pine 40 in diam bears N20°E 13 lks dist marked 1/4 S BT  
 A pine 24 in diam bears S80°W 40 lks dist marked 1/4 S BT

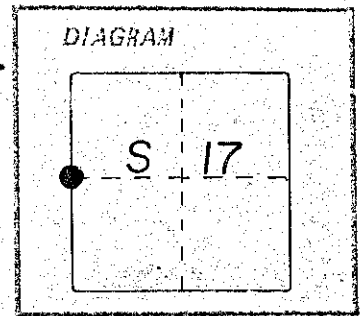

Description of corner evidence found:

- Found stone, call size, no marks visible
- Found 40 in diam pine stump, BT visible, N20°E, 8.6 feet
- Found 28 in diam pine dead and down, scribes visible, S80°W 26.4 feet

Description of monument and accessories established to perpetuate the original location of this corner:


In place of stone, I set a 2 1/2"x30" aluminum pipe with aluminum cap marked as shown 28 inches in the ground, from which;

NEW BTs

- A 14 in diam P.Pine bears N42°E 12.0 feet marked 1/4 S17 BT
- A 12 in diam red fir bears N6°W 14.9 feet marked 1/4 S18 BT

- Buried stone South and alongside of monument
- Raised mound of stone around monument
- Set steel fence post approximately 5 feet Northerly with 54-4 sign attached
- Corner set October 17, 1982
- Witnesses: Greg Blackman, Rick Robinson and Ray Crapo

**I hereby certify this corner was re-established as hereon described on the date written above**

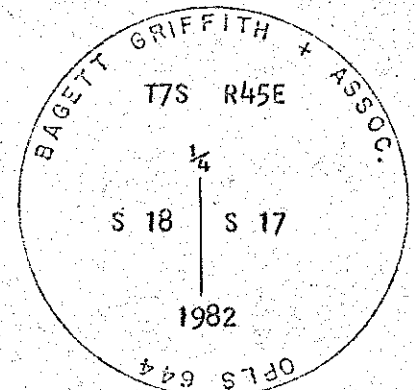

**REGISTERED PROFESSIONAL LAND SURVEYOR**

*Handwritten signature of Duane I. Griffith*

OREGON  
 JULY 10, 1984  
**DUANE I. GRIFFITH**  
 644

I used a steel tape and magnetic compass in the establishment of accessories. I used 20° East magnetic declination, and distances to the new BTs are to the center of the tree. I placed a brass washer marked OPLS 644 by the BT blaze of new BTs.

Office of..... County of.....  
 State of....., I hereby certify that the within instrument was filed in this office for record on the..... day of....., 19.....  
 ..... by .....  
 (COUNTY OFFICIAL) (DEPUTY)