


CERTIFIED RECORD OF LAND CORNER MONUMENTATION

History of original corner establishment:
 Corner originally established by W.B. Barr under GLO contract No. 443, dated May 29, 1882. Surveyor General record states;
 Set volcanic rock 18x14x10 ins 12 inches in ground for corner to Sec 7,8,17,18 marked with 4 notches on the South and 5 notches on the East edges, from which,

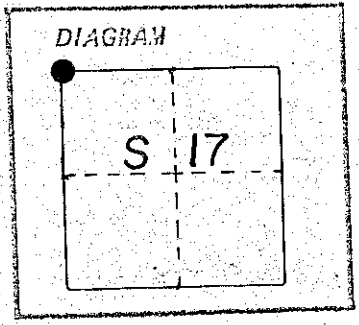

- A pine 4 in diam bears N35°E 16 lks dist marked T7S R45E S8 BT
- A pine 8 in diam bears N15°W 37 lks dist marked T7S R45E S7 BT
- A pine 5 in diam bears S53°W 57 lks dist marked T7S R45E S18 BT
- A pine 4 in diam bears S56°E 17 lks dist marked T7S R45E S17 BT

Description of corner evidence found:


- Found 24 in diam pine S16°W 36.6 feet live and vigorous, blaze evident, did not open
- Found 24 in diam pine N4°W 24.4 feet live and vigorous, scribes visible
- Found stone at distance intersect from BTs, no marks visible

Description of monument and accessories established to perpetuate the original location of this corner:

At record distance from the above described BTs, I set a 2 1/2"x30" aluminum pipe with aluminum cap marked as shown, 30 inches in the ground from which:

- NEW BTs
- A 12 in diam tamarack bears N47°E, 32.6 feet marked T7S R45E S8 BT
 - A 18 in diam pine bears S74°E, 6.0 feet marked T7S R45E S17 BT

- Buried stone East and alongside monument
- Raised mound of stone around monument
- Set steel fence post approximately 5 feet Westerly with 54-4 sign attached
- Corner set October 17, 1982
- Witnesses: Greg Blackman, Rick Robinson and Ray Crapo

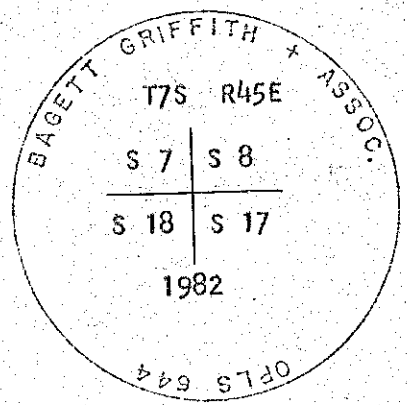

I hereby certify this corner was re-established as hereon described on the date written above

REGISTERED PROFESSIONAL LAND SURVEYOR

Duane I. Griffith

OREGON
 JULY 10, 1964
DUANE I. GRIFFITH
 644

I used a steel tape and magnetic compass in the establishment of accessories. I used 20° East magnetic declination, and distances to the new BTs are to the center of the tree. I placed a brass washer marked OPLS 644 by the BT blaze of new BTs.

Office of..... County of.....
 State of....., I hereby certify that the within instrument was filed in this office for record on the..... day of....., 19.....
 by
 (COUNTY OFFICIAL) (DEPUTY)

FILED Sept 16 1983
 BAKER COUNTY SURVEYOR
 SURVEY NO. 7-45-113

8:30-73/275
 14