


CERTIFIED RECORD OF LAND CORNER MONUMENTATION

History of original corner establishment:
 Corner originally established by W.B. Barr under GLO contract No. 443, dated May 29, 1882. Surveyor General record states;
 Set basalt rock 15x10x7 ins 10 inches in ground for 1/4 Sec corner marked 1/4 on the North side, from which,
 A fir 26 in diam bears N10°E 12 lks dist marked 1/4 S BT
 A quaking aspen 4 in diam bears S81°W 48 lks dist marked 1/4 S BT

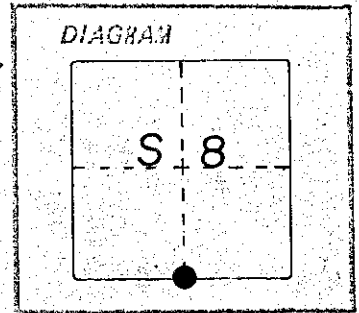

Description of corner evidence found:

Found the Northeast BT, now a stump, with BT scribes visible.

Description of monument and accessories I established to perpetuate the original location of this corner:


At record bearing and distance from the BT stump, I set a 2 1/2" x 30" aluminum pipe with aluminum cap marked as shown, 26 inches in the ground, from which:

NEW BTs

A 16 in diam red fir bears N41°E 87.8 feet marked 1/4 S8 BT
 A 20 in diam tamarack bears S39°E 92.5 feet marked 1/4 S17 BT

Raised mound of stone around monument.
 Set steel fence post approximately 5 feet Westerly with 54-4 sign attached
 Corner set October 17, 1982
 Witness: Greg Blackman

I hereby certify this corner was re-established as hereon described on the date written above

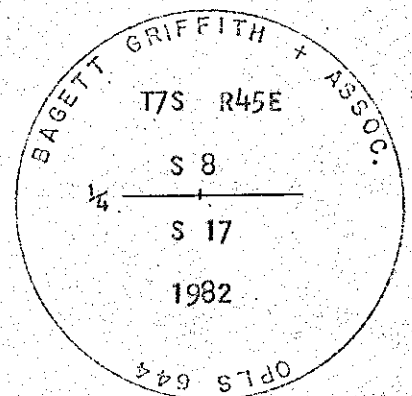

**REGISTERED
 PROFESSIONAL
 LAND SURVEYOR**

Duane I. Griffith

OREGON
 JULY 10, 1964
DUANE I. GRIFFITH
 644

I used a steel tape and magnetic compass in the establishment of accessories. I used 20° East magnetic declination, and distances to the new BTs are to the center of the tree. I placed a brass washer marked OPLS 644 by the BT blaze of new BTs.

Office of..... County of.....
 State of....., I hereby certify that the within instrument was filed in this office for record on the..... day of....., 19.....
 by
 (COUNTY OFFICIAL) (DEPUTY)

Form RS-7100-57 (9/71)

FILED Sept 16 1983
 BAKER COUNTY SURVEYOR
 SURVEY NO. 7-45-114

15 ✓