

History of original corner establishment:


Corner originally established by W.B. Barr under GLO contract No. 443, dated May 29, 1882. Surveyor General record states;

Set basalt rock 20x6x6 ins $\frac{1}{4}$ inches in the ground for corner to sec 7, 12, 13, 18 marked with 2 notches on the N and 4 notches on the S edges from which a Fir 20 in diam bears N28°E 10 lks dist marked T7S R46E S7 BT

A fir 34 in diam bears N81°W 4 lks dist marked T7S R45E S12 BT

A fir 22 in diam bears S77°W 22 lks dist marked T7S R45E S13 BT

A fir 36 in diam bears S50°E 12 lks dist marked T7S R46E S18 BT

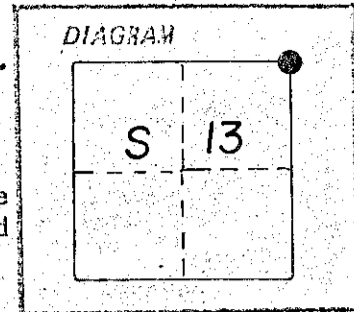

Description of corner evidence found:

Found the Southeast, Southwest, and Northwest BTs, dead and rotting, with scribes visible on the Northwest and Southeast trees.

Description of monument and accessories I established to perpetuate the original location of this corner:

At record distance from the original BTs, I set a 2 $\frac{1}{2}$ "x30" iron pipe with brass cap marked as shown, 27 inches in the ground, from which:

NEW BTs

A 20 in diam white fir bears N80°E, 52.5 feet, marked T7S R46E S7 BT

A 10 in diam white fir bears S25°E, 14.6 feet, marked T7S R46E S18 BT


A 10 in diam white fir bears S52°W, 6.5 feet, marked T7S R45E S13 BT

A 12 in diam P.Pine bears N9°W, 109.9 feet, marked T7S R45E S12 BT

Set steel fence post approximately 5 feet North with 54-4 sign attached

Corner set on November 21, 1981

Witnesses: Greg Blackman and Rick Robinson

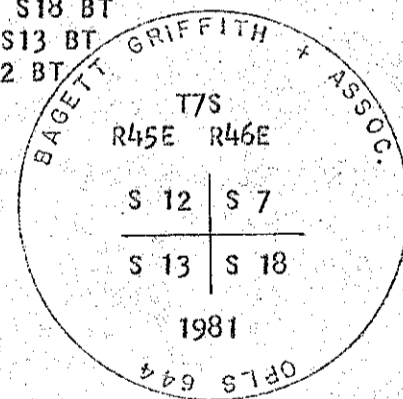

REGISTERED PROFESSIONAL LAND SURVEYOR

Duane I. Griffith

OREGON JULY 10, 1964 DUANE I. GRIFFITH 644

I hereby certify this corner was re-established as hereon described on the date written above

I used a steel tape and magnetic compass in the establishment of accessories. I used 20° East magnetic declination, and distances to the new BTs are to the center of the tree. I placed a brass washer marked OPLS 644 by the BT blaze of new BTs.

Office of..... County of.....
 State of....., I hereby certify that the within instrument was filed in this office
 for record on the..... day of....., 19.....
 by.....
 (COUNTY OFFICIAL) (DEPUTY)