


CERTIFIED RECORD OF LAND CORNER MONUMENTATION

History of original corner establishment:
 Corner originally established by W.B. Barr under GLO contract No 443, dated May 29, 1882. Surveyor General record states:

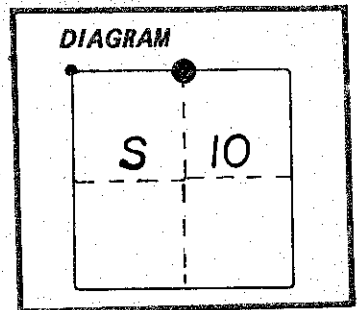

Set Iron rock 12x8x6 ins 8 inches in ground for 1/4 Sec corner marked 1/4 on the North side from which a fir 13 in diam bears S10°E 6 lks dist marked 1/4S BT, A fir 9 ins diam bears N70°W, 44 lks dist marked 1/4S BT.

Corner remonumented by A. Joseph Garrison, under U.S. Survey/ Group No. 350, dated June 16, 1975. Official record states in part: determined corner position from remains of the original bearing trees: A white fir, 27 ins diam bears N70°W, 44 lks dist with scribes visible. At the corner point set an iron post with brass cap from which a new bearing tree; A white fir 9 ins diam bears S83 3/4°W 36 lks dist marked 1/4 S10 BT

Description of corner evidence found:

- Found standard BLM brass cap marked as shown below in small mound of stone
- Found Southwest BT live and vigorous
- Found Northwest BT Dead

Description of monument and accessories established to perpetuate the original location of this corner:

From the above described monument:
 NEW BT

A 11 in diam white fir bears N26°W 16.8 feet marked 1/4 S3 BT

Set steel fence post approximately 3 feet East of the monument with 54-4 sign attached

Corner updated November 21, 1981

Witnesses: Greg Blackman and Rick Robinson


I hereby certify this corner was re-established as hereon described on the date written above

I used a steel tape and magnetic compass in the establishment of these accessories. I used 20° East magnetic declination, and distance to the new BT is to the center of the tree. I placed a brass washer marked OPLS 644 by the BT blaze on the new BT.

**REGISTERED
 PROFESSIONAL
 LAND SURVEYOR**

Duane I. Griffith

OREGON
 JULY 10, 1964
DUANE I. GRIFFITH
 644

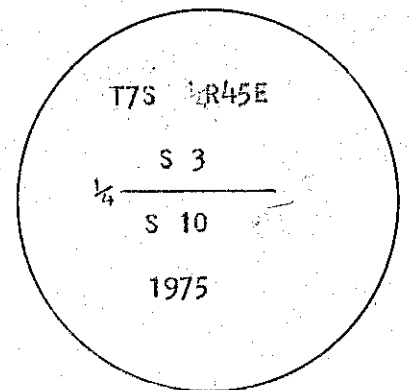

Office of..... County of.....
 State of....., I hereby certify that the within instrument was filed in this office
 for record on the..... day of....., 19.....
 by
 (COUNTY OFFICIAL) (DEPUTY)

Form R6-7100-57 (9/71)

FILED Sept 16, 1983
 BAKER COUNTY SURVEYOR
 SURVEY NO. 7-45-116