


CERTIFIED RECORD OF LAND CORNER MONUMENTATION

History of original corner establishment:

Corner originally established by W.B. Barr under GLO contract No. 443, dated May 29, 1882. Surveyor General record states;  
 Set basalt rock 13x12x5 ins 9 inches in ground for corner to Sec 4,5,8,9 marked with 5 notches on the South and 4 notches on the East edges from which,  
 A maple 3 in diam bears N15°E 17 lks dist marked T7S R45E S4 BT  
 A fir 10 in diam bears N30°W 136 lks dist marked T7S R45E S5 BT  
 A quaking aspen 4 in diam bears S20°W 20 lks dist marked T7S R45E S8 BT

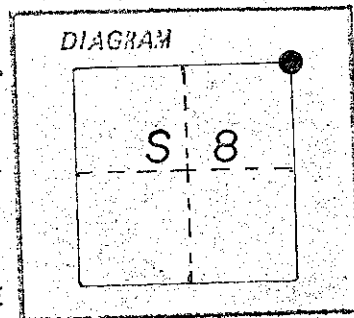

No other trees within limits, raised mound of rock alongside; pits impracticable

Description of corner evidence found:

Found marked stone, call size in mound of stone

Found 36 in diam fir live and vigorous, blaze evident, did not open, tree bears N30°W, 85.6 feet from stone


Description of monument and accessories established to perpetuate the original location of this corner:

In place of stone, I set a 2 1/2"x30" aluminum pipe with aluminum cap marked as shown, 26 inches in the ground from which:

NEW BTs

A rock outcrop marked + on top with B0 on South face bears N17°E, 44.6 feet  
 A 12 in diam cottonwood bears S24°E, 13.9 feet marked T7S R45E S9 BT  
 A 6 in diam cottonwood bears S8°W, 18.4 feet marked X BT

Buried stone East and alongside monument  
 Raised mound of stone around monument  
 Set steel fence post approximately 5 feet Southerly with 54-4 sign attached  
 Corner set October 17, 1982  
 Witnesses: Greg Blackman, Rick Robinson and Ray Crapo

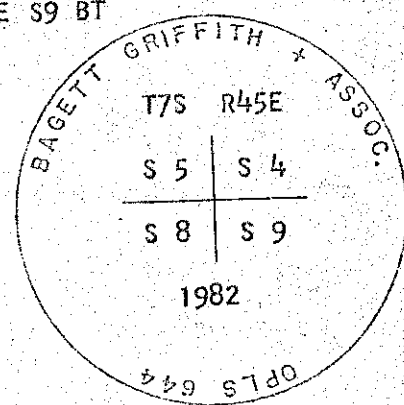

I hereby certify this corner was re-established as hereon described on the date written above

**REGISTERED PROFESSIONAL LAND SURVEYOR**

*Handwritten signature of Duane I. Griffith*

OREGON  
 JULY 10, 1984  
**DUANE I. GRIFFITH**  
 644

I used a steel tape and magnetic compass in the establishment of accessories. I used 20° East magnetic declination, and distances to the new BTs are to the center of the tree. I placed a brass washer marked OPLS 644 by the BT blaze of new BTs.

Office of..... County of.....  
 State of....., I hereby certify that the within instrument was filed in this office  
 for record on the..... day of....., 19.....  
 ..... by .....  
 (COUNTY OFFICIAL) (DEPUTY)

18