

CERTIFIED RECORD OF LAND CORNER MONUMENTATION


History of original corner establishment:

Corner originally established by W.B. Barr under GLO contract No. 443, dated May 29, 1882. Surveyor General record states;

Set lime stone 12x10x5 ins 8 inches in ground for 1/4 Sec corner, marked 1/4 on the West side from which:

A tamarack 24 in diam bears S35°W 50 lks dist marked 1/4 S BT

A fir 5 in diam bears N70°E 46 lks dist marked 1/4 S BT

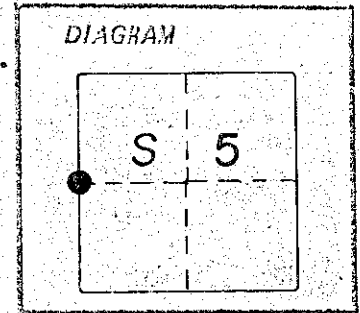

Description of corner evidence found:

Found the Southwest BT, now a 25 in diam dead snag with scribes visible

Description of monument and accessories I established to perpetuate the original location of this corner:

At record bearing and distance from the Southwest BT, I set a 2 1/2" x 30" aluminum pipe with aluminum cap marked as shown, 20 inches in the ground, from which:  
NEW BTs

A 44 in diam tamarack bears N14°E 78.2 feet, marked 1/4 S5 BT  
A 24 in diam red fir bears S29°W 105.9 feet, marked 1/4 S6 BT

Raised mound of stone around monument  
Set steel fence post approximately 5 feet North with 54-4 sign attached


Corner set August 31, 1982  
Witnesses: Greg Blackman and Ray Crapo

I hereby certify this corner was re-established as hereon described on the date written above

REGISTERED PROFESSIONAL LAND SURVEYOR

*Duane J. Griffith*

OREGON JULY 10, 1964 DUANE J. GRIFFITH 644

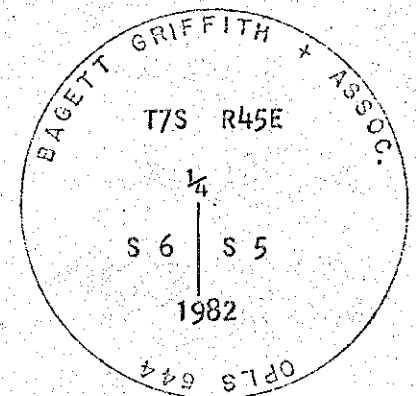

I used a steel tape and magnetic compass in the establishment of accessories. I used 20° East magnetic declination, and distances to the new BTs are to the center of the tree. I placed a brass washer marked OPLS 644 by the BT blaze of new BTs.

Office of..... County of.....  
State of....., I hereby certify that the within instrument was filed in this office for record on the..... day of....., 19.....  
..... by .....  
(COUNTY OFFICIAL) (DEPUTY)

Form R6-7100-57 (9/71)

FILED Sept 16, 1983

BAKER COUNTY SURVEYOR  
SURVEY NO. 7-45-118

NSPS-713-215

19