


CERTIFIED RECORD OF LAND CORNER MONUMENTATION

History of original corner establishment:

Corner originally established by W.B. Barr under GLO contract No 443, dated May 29, 1882. Surveyor General record states: Set basalt rock 15x8x5 ins 10 inches in ground for corner to Sec 1,2,35,36 marked with 1 notch in the East and 5 notches on the West sides, from which a fir 10 in diam bears N65°E 25 lks dist marked T6SR45ES36BT a fir 8 in diam bears N45°W 34 lks dist marked T6SR45ES35BT a fir 16 in diam bears S65°W 50 lks dist marked T7SR45ES28T a tamarack 14 in diam bears S27°E 19 lks dist marked T7SR45ES18T. Corner remonumented by Lester A. Fischer for the BLM under U.S. Survey Group No. 350 dated August 22, 1974. Official record states in part: The corner position was determined from the record bearing and distance from the remains of the Southeast and Southwest BTs. Set an iron post with brass cap from which: A subalpine fir 8 in diam bears N83°E 47 lks dist marked T6S R45E S36 BT A white fir 8 in diam bears S22°E 23 lks dist marked T7S R45E S1 BT A lodgepole pine 8 in diam bears N78°W 11 lks dist marked T6S R45E S35 BT. No other trees available.

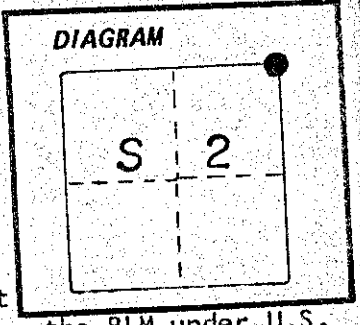

Description of corner evidence found:

Found standard BLM brass cap marked as shown below  
 Found all BTs taken by the BLM live and vigorous

Description of monument and accessories established to perpetuate the original location of this corner:

From the above described monument:

NEW BT

A 20 in diam white fir bears S13°W, 87.3 feet marked T7S R45E S2 BT

Set steel fence post approximately 5 feet North with 54-4 sign attached

Corner updated November 21, 1981

Witnesses: Greg Blackman and Rick Robinson


**I hereby certify this corner was re-established as hereon described on the date written above**

I used a steel tape and magnetic compass in the establishment of accessories I used 20° East magnetic declination, and distance to the new BT is to the center of the tree. I placed a brass washer marked OPLS 644 by the BT blaze on the new BT

**REGISTERED  
PROFESSIONAL  
LAND SURVEYOR**

*Duane I. Griffith*

OREGON  
JULY 10, 1964  
**DUANE I. GRIFFITH**  
644

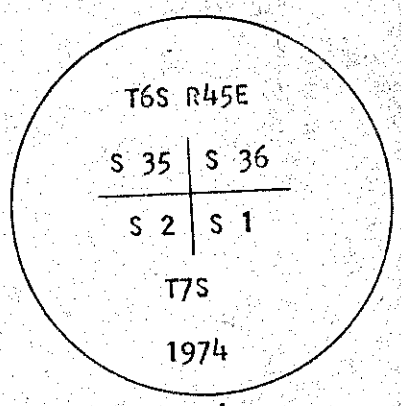

Office of..... County of.....  
 State of....., I hereby certify that the within instrument was filed in this office  
 for record on the..... day of....., 19.....  
 ..... by .....  
 (COUNTY OFFICIAL) (DEPUTY)

(9/71)

FILED Sept 16 1983  
 BAKER COUNTY SURVEYOR  
 SURVEY NO. 6-45-35  
7-45-119