


History of original corner establishment:

Corner originally established by W.B. Barr under GLO contract No. 443, dated May 29, 1882. Surveyor General record states;

Set granite rock 16x11x6 ins 11 inches in ground for corner to sec 3,4,33,34 marked with 3 notches on the East and West sides from which:

- A cottonwood 10 in diam bears N81°E 15 lks dist marked T6SR45E S34 BT
- A cottonwood 12 in diam bears N52°W 17 lks dist marked T6S R45E S33 BT
- A fir 14 in diam bears S5°W 70 lks dist marked T7S R45E S4 BT
- A fir 12 in diam bears S31°E 44 lks dist marked T7S R45E S3 BT

Corner remonumented by James H Hambleton (form dated march 23, 1981) record states in part: Corner destroyed by flash flooding, found evidence of both firs and cottonwood in Section 4. I relocated the corner from this evidence, setting a brass cap in mound of stone from which: A red fir 40 in diam bears N34°W 81.84 feet marked T6S R45E S34 BT. A pine 28 in diam bears N40 30E 142.43 feet dist scribed T6S R45E S33 BT. A red fir 40 in diam bears S29 30E 33.66 feet scribed T7S R45E S3 BT. A spike in point of a vertical rock ledge 20 feet high bears S74°30'W 73.8 feet, the only suitable bearing object

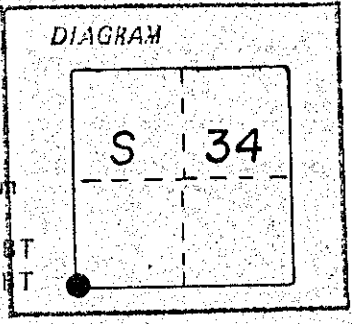

I found all of Hambleton's bearing trees and object none of which come together at record data. It was determined that the distances given by Hambleton were SLOPE DISTANCES. The position was then determined for the corner and the true ties to the bearing trees and objects taken by Hambleton are as follows:

- A 28 in diam pine bears N42°E 131.6 feet, scribes visible
- A 40 in diam red fir bears S30°E 28.6 feet, scribes visible
- A spike in vertical rock ledge 20 feet high bears S74°30'W 73.8 feet
- A 40 in diam red fir bears N36°W 76.0 feet, scribes visible


Hambleton's brass cap has been destroyed by flooding

Description of monument and accessories I established to perpetuate the original location of this corner:

Because of past destruction of this corner, I set a witness corner on the Section line between sections 33 and 34, said point being N5°34'32"W, 21.00 feet from the true section corner, said witness corner being a 2 1/2"x30" aluminum pipe with aluminum cap marked as shown, 20 inches in the ground, I did not take new BTs for the witness corner in an attempt to avoid confusion. The ties to the existing bearing trees and object from the witness corner are as follows:

- The above described Northeast BT bears N50°E 118.5 feet
- The above described Southeast BT bears S20°E 48.5 feet
- The above described Southwest BT bears S60°W 80.1 feet
- The above described Northwest BT bears N47°W 58.9 feet

Raised mound of stone around monument  
 Set steel fence post approximately 5 feet  
 Northerly with 54-4 sign attached  
 Witness corner set September 10, 1982  
 Witnesses: Greg Blackman, Rick Robinson and Ray Crapo  
 See survey dated December, 1982

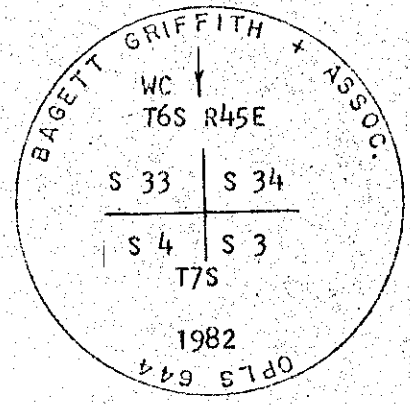

REGISTERED PROFESSIONAL LAND SURVEYOR

*Handwritten signature of Duane I. Griffith*

OREGON JULY 10, 1964 DUANE I. GRIFFITH 644

I hereby certify this corner was re-established as hereon described on the date written above

I used a steel tape and magnetic compass in the establishment of accessories. I used 20° East magnetic declination, and distances to the new BTs are to the center of the tree. I placed a brass washer marked OPLS 644 by the BT blaze of new BTs.

Office of..... County of.....  
 State of....., I hereby certify that the within instrument was filed in this office  
 for record on the..... day of....., 19.....  
 by..... (COUNTY OFFICIAL) (DEPUTY)

Form RS-7100-57 (9/71)

FILED Sept 16, 1983  
 BAKER COUNTY SURVEYOR  
 SURVEY NO. 6-45-36  
7-45-120

24