


CERTIFIED RECORD OF LAND CORNER MONUMENTATION

Index File Number G-13

History of original corner establishment:

Corner was originally established under G. L. O. contract number 443, by W. B. Barr, on August 5, 1882. Surveyor General's notes state: "Set volcanic rock 14 X 12 X 6 ins. 10 inches in ground for 1/4 sec. corner, marked 1/4 on the west side. from which a Pine 6 ins. diam. bears N26°E, 25 lks. dist. marked 1/4 S BT. A Fir 7 ins. diam. bears N19°W, 45 lks. dist. marked 1/4 S BT."

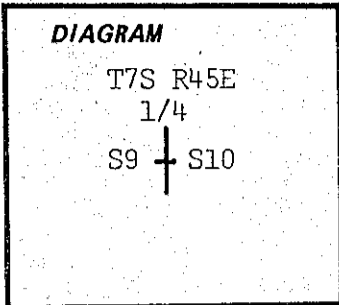


Description of corner evidence found:

Found no trace of record stone or bearing trees. Corner falls on steep north slope, with unstable soil. Corner falls about 100 ft. south of an east flowing creek. No call for creek in notes.

Description of monument and accessories I established to perpetuate the original location of this corner:

At surveyed point set 2 1/2 X 30" galvanized pipe and brass cap marked: Set pipe 25" in the ground and mound of stone around to cap.

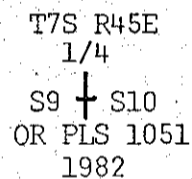

From which by magnetic declination of N20°E: A 6" Fir bears S75°E, 5.5 ft. scribed 1/4 S10 BT. An 8" Fir bears S56°W, 27.7 ft. scribed 1/4 S9 BT. Painted blazes red and 6" red band around. Placed 54-3s, 54-4s and brass washers stamped PLS 1051 on the bearing trees. Placed 54-4 on a steel fence post 5' north of the corner.

I hereby certify that the above corner monument was reestablished as herein described.

Witnesses: Larry D. Shirley Terry J. Anderson

September 1, 1982.

REGISTERED PROFESSIONAL LAND SURVEYOR

BARRY B. BARBOUR OREGON OCT. 17, 1975 BARRY B. BARBOUR 1051

Office of..... County Surveyor..... County of..... Baker Oregon State of....., I hereby certify that the within instrument was filed in this office for record on the..... day of....., 1985 by..... (COUNTY OFFICIAL) (DEPUTY)

FILED 11-7-85 BAKER COUNTY SURVEYOR SURVEY NO. 7-45-124