


CERTIFIED RECORD OF LAND CORNER MONUMENTATION

Index File Number G-14

History of original corner establishment:

Not Set.

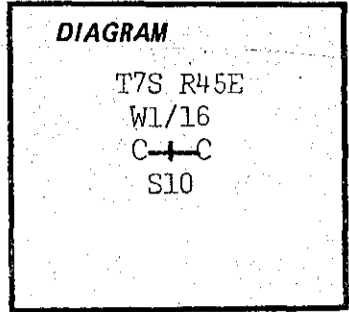

Description of corner evidence found:

None Found.

Description of monument and accessories I established to perpetuate the original location of this corner:

At surveyed point set 2 1/2" X 30" galvanized pipe and
brass cap marked:
Set pipe 26" in the ground. No rock in the area.
From which by magnetic declination of N20°E:
A 20" Fir bears S48°W, 27.4 ft. scribed CW 1/16 S10 BT.
A 12" Tamarack bears N40°W, 23.8 ft. scribed CW 1/16 S10 BT.
Painted blazes red and 6" red band around. Placed 54-3s, 54-9s and brass
washers stamped PLS 1051 on the bearing trees. Placed 54-2 and 54-9 on a
steel fence post 5' north and placed 54-2 on a steel fence post 5' south
of the corner.

T7S R45E
W1/16
C—C
S10
OR PLS 1051
1982

I hereby certify that the above corner monument was established as herein described.

Witnesses: Larry D. Shirley
Terry J. Anderson

August 27, 1982.

REGISTERED
PROFESSIONAL
LAND SURVEYOR

Barry B. Barbour

OREGON
OCT. 17, 1975
BARRY B. BARBOUR
1051

Office of.....County Surveyor..... County of.....Baker.....

State of.....Oregon....., I hereby certify that the within instrument was filed in this office for record on the..... day of....., 19.85

..... by (COUNTY OFFICIAL) (DEPUTY)

FILED 11-7-85
BAKER COUNTY SURVEYOR
SURVEY NO. 7-45-125