


CERTIFIED RECORD OF LAND CORNER MONUMENTATION

Index File Number G-15

History of original corner establishment:

Not Set.

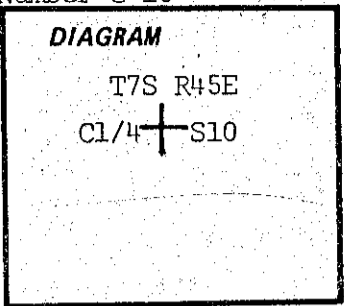

Description of corner evidence found:

None Found.

Description of monument and accessories established to perpetuate the original location of this corner:

At surveyed point set 2 1/2" X 30" galvanized pipe and brass cap marked:
Set pipe 24" in the ground and mound of stone around to cap.

T7S R45E
C1/4 + S10
OR PLS 1051
1982

From which by magnetic declination of N20°E:
A 12" Pine bears N25°E, 13.4 ft. scribed C1/4 S10 BT. A 20" Fir bears S35°W, 66.0 ft. scribed C1/4 S10 BT. Painted blazes red and 6" red band around. Placed 54-3s, 54-9s and brass washers stamped PLS 1051 on the bearing trees. Placed 54-9 on a steel fence post 5' west of the corner. Corner falls on the edge of road bank, about 20 ft. west of the road.

I hereby certify that the above corner monument was established as herein described.

Witnesses: Larry D. Shirley
Terry J. Anderson

September 1, 1982.

REGISTERED
PROFESSIONAL
LAND SURVEYOR

Barry B. Barbour

OREGON
OCT. 17, 1975
BARRY B. BARBOUR
1051

Office of.....County Surveyor..... County of.....~~Wagon~~ Baker.....
State of.....Oregon....., I hereby certify that the within instrument was filed in this office
for record on the..... day of....., 1985.

..... by
(COUNTY OFFICIAL) (DEPUTY)

FILED 11-7-85
BAKER COUNTY SURVEYOR
SURVEY NO. 7-45-126