


CERTIFIED RECORD OF LAND CORNER MONUMENTATION

Index File Number H-15

History of original corner establishment:

Not Set.

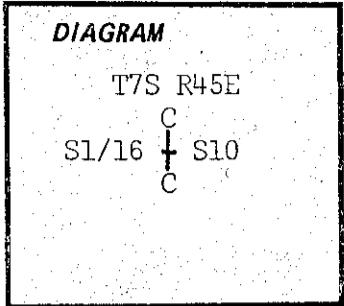


Description of corner evidence found:

None Found.

Description of monument and accessories established to perpetuate the original location of this corner:

At surveyed point set 2 1/2" X 30" galvanized pipe and brass cap marked:  
Set pipe 24" in the ground and mound of stone around to cap.

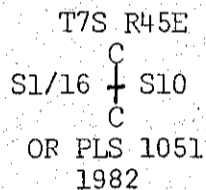

From which by magnetic declination of N20°E:  
A 12" Fir bears S68°E, 35.6 ft. scribed CS 1/16 S10 BT.  
A 14" Tamarack bears S56°W, 31.7 ft. scribed CS 1/16 S10 BT. Painted blazes red and 6" red band around. Placed 54-3s, 54-9s and brass washers stamped PLS 1051 on the bearing trees. Placed 54-2 and 54-9 on a steel fence post 5' east and placed 54-2 on a steel fence post 5' west of the corner.

I hereby certify that the above corner monument was established as herein described.

Witnesses: Larry D. Shirley  
Terry J. Anderson

August 26, 1982.

REGISTERED  
PROFESSIONAL  
LAND SURVEYOR

*Barry B. Barbour*

OREGON  
OCT. 17, 1975  
BARRY B. BARBOUR  
1051

Office of.....County Surveyor..... County of..... Baker.....  
State of..... Oregon....., I hereby certify that the within instrument was filed in this office  
for record on the..... day of....., 1985.

..... by .....

(COUNTY OFFICIAL)

(DEPUTY)