


CERTIFIED RECORD OF LAND CORNER MONUMENTATION

Index File Number J-13

History of original corner establishment:

Corner was originally established under G. L. O. contract number 443, by W. B. Barr, on August 5, 1882. Surveyor General's notes state: Set basalt rock 12 X 12 X 6 ins., 8 inches in the ground for cor. to secs. 9, 10, 15 & 16, marked with 3 notches on the east and 4 notches on the south edges, From which a fir 26 ins. in diam. bears N70°E, 18 lks. dist. marked T7S R45E S10 BT. A Fir 26 ins. diam. bears N68°W, 30 lks. dist. marked T7S R45E S9 BT. A fir 22 ins. diam. bears S36°W, 14 lks. dist. marked T7S R45E S16 BT. A fir 5 ins. diam. bears S70°E, 18 lks. dist. marked T7S R45E S15 BT."

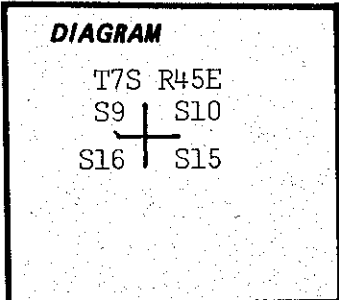

Description of corner evidence found:


No trace of record corner stone or bearing trees could be found. Area has not been logged.

Corner falls about 65 ft. north of main ridge, which fits the topographic call.

Corner was set by me in 1978 and was re-surveyed in 1982. The corner was found as described in R6-7100-57 filed with the County Surveyor in 1978.

Description of monument and accessories established to perpetuate the original location of this corner:

The corner was moved 2.10 ft. south in 1982 to fit the new survey measurements. At surveyed point set 2 1/2" X 30" galvanized pipe and brass cap marked: Set pipe 16" in the ground to bedrock and mound of stone around to cap.

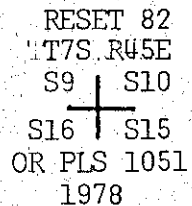

From which by magnetic declination of N20°E:
A 12" Pine bears N69°E, 37.5 ft. scribed T7S R45E S10 BT.
A 14" Fir bears S24°E, 81.9 ft. scribed T7S R45E S15 BT. An 18" Fir bears S09 1/2°W, 35.4 ft. scribed T7S R45E S16 BT. A 9" Fir bears N30°W, 39.3 ft. scribed T7S R45E S9 BT. Painted blazes red and 6" red band around. Placed 54-3s, 54-4s and brass washers stamped PLS 1051 on the bearing trees. Placed 54-4 on a steel fence post 5' west of the corner.

I hereby certify that the above corner monument was reestablished as herein described.

Witnesses: Larry D. Shirley
Terry J. Anderson

September 2, 1982.

REGISTERED
PROFESSIONAL
LAND SURVEYOR

Barry B. Barbour

OREGON
OCT. 17, 1975
BARRY B. BARBOUR
1051

Office of.....County Surveyor..... County of..... Baker
Oregon
State of....., I hereby certify that the within instrument was filed in this office
for record on the..... day of....., 19.85
..... by
(COUNTY OFFICIAL) (DEPUTY)