


CERTIFIED RECORD OF LAND CORNER MONUMENTATION

Index File Number J-15

History of original corner establishment:

Corner was originally established under G. L. O. contract number 443, by W. B. Barr, on August 5, 1882. Surveyor General's notes state: "Set iron rock 14 X 12 X 5 ins. 10 ins. in the ground for 1/4 sec. cor. From which a pine 9 ins. diam. bears N78°W, 47 lks. dist. marked 1/4 S BT. A pine 9 ins. diam. bears S16°W, 40 lks. dist. marked 1/4 S BT."

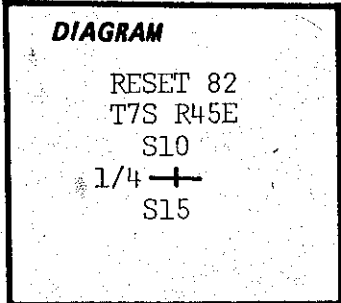

Description of corner evidence found:

No trace of record stone or bearing trees could be found.

Corner falls on southeast slope, about 150 ft. south of an east-west ridge.

The corner was set by me in 1978 and was re-surveyed in 1982. The corner was found as described in R6-7100-57 filed with the County Surveyor in 1978.

Description of monument and accessories established to perpetuate the original location of this corner:

The corner was moved 1.05 ft. south in 1982 to fit the new survey measurements. At surveyed point set 2 1/2" X 30" galvanized pipe and brass cap marked: Set pipe 25" in the ground and mound of stone around to cap.

RESET 82
T7S R45E
S10
1/4 —+—
S15
OR PLS 1051
1978

From which by magnetic declination of N20°E:
A 10" Pine bears N22°E, 15.3 ft. scribed 1/4 S10 BT.
A 28" Pine bears S12°E, 27.1 ft. scribed 1/4 S15 BT. Painted blazes red and 6" red band around. Placed 54-3s, 54-4s and brass washers stamped PLS 1051 on the bearing trees. Placed 54-4 on a steel fence post 5' west of the corner. Placed 54-5 on a Pine, 25 ft. south of the corner.

I hereby certify that the above corner monument was reestablished as herein described.

Witnesses: Larry D. Shirley
Terry J. Anderson

September 2, 1982.

REGISTERED
PROFESSIONAL
LAND SURVEYOR

Barry B. Barbour

OREGON
OCT. 17, 1975
BARRY B. BARBOUR
1051

Office of..... County Surveyor..... County of..... Baker
Oregon
State of..... I hereby certify that the within instrument was filed in this office
for record on the..... day of....., 1985
..... by
(COUNTY OFFICIAL) (DEPUTY)