


CERTIFIED RECORD OF LAND CORNER MONUMENTATION

Index File Number K-16

History of original corner establishment:

Corner was set by me in 1978 and re-surveyed in 1982.

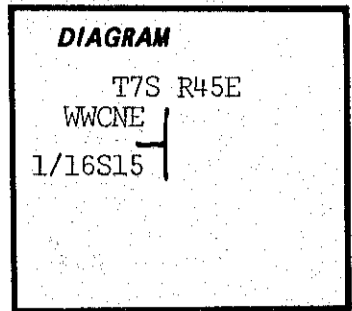

Description of corner evidence found:

The corner was found as described in R6-7100-57 filed with the County Surveyor in 1978.

Description of monument and accessories I established to perpetuate the original location of this corner:

The corner was moved 0.75 ft. south in 1985 to fit the new survey measurements. At surveyed point set 2 1/2" X 30" galvanized pipe and brass cap marked: Set pipe 24" in the ground and mound of stone around to cap.

RESET 85
 T7S R45E
 WWCNE WEST
 1/16S15 32.4 FT
 OR PLS 1051
 1978

From which by magnetic declination of N20°E:
 An 18" Fir bears N02°E, 28.7 ft. scribed WWCNE 1/16 S15 BT.
 The south witness corner bears S10° 38'E, 179.8 ft. Painted blazes red and 6" red band around. Placed 54-3, 54-9 and brass washer stamped PLS 1051 on the bearing tree. Placed 54-2 and 54-9 on a steel fence post 3' east of the corner.

I hereby certify that the above corner monument was reestablished as herein described.

Witnesses:

May 5, 1985.

REGISTERED
 PROFESSIONAL
 LAND SURVEYOR

Barry B. Barbour
 OREGON
 OCT. 17, 1975
 BARRY B. BARBOUR
 1051

Office of.....County Surveyor..... County of.....Baker.....
 State of.....Oregon..... I hereby certify that the within instrument was filed in this office
 for record on the..... day of....., 19.85
 by
 (COUNTY OFFICIAL) (DEPUTY)